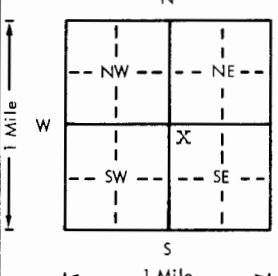
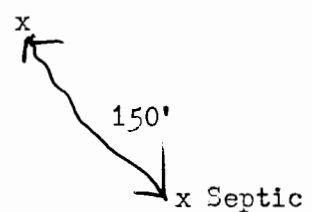


USE TYPEWRITER OR BALL POINT PEN-PRESS FIRMLY, PRINT CLEARLY.

WATER WELL RECORD
KSA 82a-1201-1215

Kansas Department of Health and Environment-Division of Environment
(Water well Contractors)
Topeka, Kansas 66620

1. Location of well:		County Scott	Fraction NW 1/4 SE 1/4 SE 1/4	Section number 25	Township number T 19 S R 33 E/W	Range number 33
2. Distance and direction from nearest town or city: 1/4 S of Shallow Water, Kansas Street address of well location if in city:				3. Owner of well: Gary Schmidt R.R. or street: City, state, zip code: Shallow Water, Kansas		
<input checked="" type="checkbox"/> Locate with "X" in section below: 		Sketch map: 		6. Bore hole dia. <u>9</u> in. Completion date <u>4/17/79</u> Well depth <u>176</u> ft.		
5. Type and color of material		From	To	7. <input checked="" type="checkbox"/> Cable tool <input checked="" type="checkbox"/> Rotary <input type="checkbox"/> Driven <input type="checkbox"/> Dug <input type="checkbox"/> Hollow rod <input type="checkbox"/> Jetted <input type="checkbox"/> Bored <input type="checkbox"/> Reverse rotary		
clay		0	22	8. Use: <input checked="" type="checkbox"/> Domestic <input type="checkbox"/> Public supply <input type="checkbox"/> Industry <input type="checkbox"/> Irrigation <input type="checkbox"/> Air conditioning <input type="checkbox"/> Stock <input type="checkbox"/> Lawn <input type="checkbox"/> Oil field water <input type="checkbox"/> Other		
sand gravel		22	31	<input checked="" type="checkbox"/> Casing: Material <u>Plastic</u> Height: Above or below Threaded <input type="checkbox"/> Welded <input checked="" type="checkbox"/> surface <u>12</u> in. RMP <input checked="" type="checkbox"/> PVC <input type="checkbox"/> Weight <u>1.8</u> lbs./ft. Dia. <u>5</u> in. to <u>156</u> ft. depth; Wall Thickness: inches or Dia. <u> </u> in. to <u> </u> ft. depth; gage No. <u>250</u>		
clay		31	53	10. Screen: Manufacturer's name <u>Jess & Lowell</u> Type <u>RMP</u> Dia. <u>5</u> Slot/gauze <u>1/16</u> Length <u>20'</u> Set between <u>156</u> ft. and <u>176</u> ft. <u> </u> ft. and <u> </u> ft. Gravel pack? <input checked="" type="checkbox"/> Size range of material <u>1/4 x 1/8</u>		
fine sand clay streaks		53	80	11. Static water level: <u>76</u> ft. below land surface Date <u>3/26/79</u> mo./day/yr.		
clay		80	86	12. Pumping level below land surfaces: <u>90</u> ft. after <u>4</u> hrs. pumping <u>10</u> g.p.m. <u> </u> ft. after <u> </u> hrs. pumping <u> </u> g.p.m. Estimated maximum yield <u>10</u> g.p.m.		
sand		86	89	13. Water sample submitted: <u> </u> mo./day/yr. <input type="checkbox"/> Yes <input checked="" type="checkbox"/> No Date <u> </u>		
sand rock		89	91	14. Well head completion: <input checked="" type="checkbox"/> Pitless adapter <u>12</u> inches above grade		
fine sand		91	100	15. Well grouted? <u>yes</u> With: <input checked="" type="checkbox"/> Neat cement <input type="checkbox"/> Bentonite <input type="checkbox"/> Concrete Depth: From <u>0</u> ft. to <u>15</u> ft.		
clay		100	160	16. Nearest source of possible contamination: ft. <u>150</u> Direction <u>Se</u> Type <u>Septic</u> Well disinfected upon completion? <input checked="" type="checkbox"/> Yes <input type="checkbox"/> No		
sand fine to medium		160	173	17. Pump: <input type="checkbox"/> Not installed Manufacturer's name <u>Sears</u> Model number <u> </u> HP <u>1</u> Volts <u>230</u> Length of drop pipe <u>173</u> ft. capacity <u>10</u> g.p.m. Type: <input checked="" type="checkbox"/> Submersible <input type="checkbox"/> Turbine <input type="checkbox"/> Jet <input type="checkbox"/> Reciprocating <input type="checkbox"/> Centrifugal <input type="checkbox"/> Other		
clay		173	176	20. Water well contractor's certification: This well was drilled under my jurisdiction and this report is true to the best of my knowledge and belief. Weishaar Drilling & supply 232 Business name <u> </u> License No. <u> </u> Address <u>Scott City, Kansas 67871</u> Signed <u>[Signature]</u> Date <u>5/4/79</u> Authorized representative		
18. Elevation:		19. Remarks:		(Use a second sheet if needed)		
Topography: <input type="checkbox"/> Hill <input type="checkbox"/> Slope <input checked="" type="checkbox"/> Upland <input type="checkbox"/> Valley						

T 19 S R 33 E - 25 NW/4 SE

Forward the white, blue and pink copies to the Department of Health and Environment

Farm WWC-5