


1 LOCATION OF WATER WELL: Fraction SE Section Number 25 Township Number T 19 S Range Number R 33 EW
 County: Scott SW 1/4 ~~SE~~ 1/4 NE 1/4

Distance and direction from nearest town or city street address of well if located within city?
7 1/2 miles South 4 1/2 miles west of Scott City, Kansas 1/2 S 1/10 W

2 WATER WELL OWNER: Carl Elliott
 RR#, St. Address, Box #: R R # 2 Box 97 Board of Agriculture, Division of Water Resources
 City, State, ZIP Code: Scott City, Kansas 67871 Application Number:

3 LOCATE WELL'S LOCATION WITH AN "X" IN SECTION BOX:

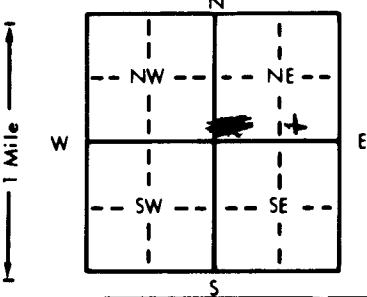

4 DEPTH OF COMPLETED WELL... 191 195 ... ft. ELEVATION:
 Depth(s) Groundwater Encountered 1... 101 ft. 2..... ft. 3..... ft.
 WELL'S STATIC WATER LEVEL... 101 ft. below land surface measured on mo/day/yr 5/11/87
 NA Pump test data: Well water was ft. after hours pumping gpm
 Est. Yield gpm: Well water was ft. after hours pumping gpm
 Bore Hole Diameter... 9 in. to 195 ft., and in. to ft.
 WELL WATER TO BE USED AS: 5 Public water supply 8 Air conditioning 11 Injection well
1 Domestic 3 Feedlot 6 Oil field water supply 9 Dewatering 12 Other (Specify below)
 2 Irrigation 4 Industrial 7 Lawn and garden only 10 Observation well
 Was a chemical/bacteriological sample submitted to Department? Yes..... No X.....; If yes, mo/day/yr sample was submitted
 Water Well Disinfected? Yes X No

5 TYPE OF CASING USED: 5 Wrought iron 8 Concrete tile CASING JOINTS: Glued Clamped
 1 Steel 3 RMP (SR) 6 Asbestos-Cement 9 Other (specify below) Welded
2 PVC 4 ABS 7 Fiberglass Threaded.....

Casing diameter... 5 in. to 175 ft., Dia..... in. to ft., Dia..... in. to ft.
 Casing height above land surface..... 12 in., weight..... 2.9 lbs./ft. Wall thickness or gauge No. 265

TYPE OF SCREEN OR PERFORATION MATERIAL: 7 PVC 10 Asbestos-cement
 1 Steel 3 Stainless steel 5 Fiberglass 8 RMP (SR) 11 Other (specify)
 2 Brass 4 Galvanized steel 6 Concrete tile 9 ABS 12 None used (open hole)

SCREEN OR PERFORATION OPENINGS ARE: 5 Gauzed wrapped 8 Saw cut 11 None (open hole)
 1 Continuous slot 3 Mill slot 6 Wire wrapped 9 Drilled holes
 2 Louvered shutter 4 Key punched 7 Torch cut 10 Other (specify)

SCREEN-PERFORATED INTERVALS: From..... 175 ft. to 195 ft., From ft. to ft.
 GRAVEL PACK INTERVALS: From..... 100 ft. to 195 ft., From ft. to ft.

6 GROUT MATERIAL: 1 Neat cement 2 Cement grout 3 Bentonite 4 Other Drill Cuttings.....
 Grout Intervals: From... 25 ft. to 100 ft., From... 4 ft. to 25 ft., From ft. to ft.

What is the nearest source of possible contamination:
1 Septic tank 4 Lateral lines 7 Pit privy 10 Livestock pens 14 Abandoned water well
 2 Sewer lines 5 Cess pool 8 Sewage lagoon 11 Fuel storage 15 Oil well/Gas well
 3 Watertight sewer lines 6 Seepage pit 9 Feedyard 12 Fertilizer storage 16 Other (specify below)
 13 Insecticide storage
 Direction from well? Southwest How many feet? 100

FROM	TO	LITHOLOGIC LOG	FROM	TO	LITHOLOGIC LOG
0	10	01 Clay	10	25	01 Clay
25	39	07 Fine sand	39	50	07 Fine sand clay streaks
50	60	01 Clay	60	105	07 Fine sand clay streaks
105	113	05 Sand medium	113	120	07 Fine sand clay streaks
120	142	01 Clay	142	150	07 Fine sand clay streaks
160	160	08 Medium sand clay streaks	160	186	04 Clay fine sand streaks
186	192	05 Sand	192	195	01 Yellow clay

7 CONTRACTOR'S OR LANDOWNER'S CERTIFICATION: This water well was (1) constructed, (2) reconstructed, or (3) plugged under my jurisdiction and was completed on (mo/day/year) 5/13/87 and this record is true to the best of my knowledge and belief. Kansas Water Well Contractor's License No. 232 This Water Well Record was completed on (mo/day/yr) 5/15/87 under the business name of Weishaar Drilling & Supply Inc. by (signature) [Signature]

INSTRUCTIONS: Use typewriter or ball point pen, PLEASE PRESS FIRMLY and PRINT clearly. Please fill in blanks, underline or circle the correct answers. Send top three copies to Kansas Department of Health and Environment, Division of Environment, Environmental Geology Section, Topeka, KS 66620. Send one to WATER WELL OWNER and retain one for your records.

OFFICE USE ONLY T R EW SEC. 1/4 1/4 1/4