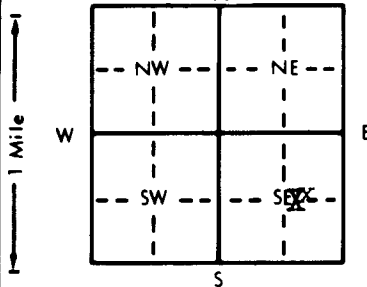


1 LOCATION OF WATER WELL: Fraction $\frac{1}{4}$ N $\frac{1}{4}$ SE $\frac{1}{2}$ Section Number 25 Township Number T 19 S Range Number R 33 EW
 County: Scott

Distance and direction from nearest town or city street address of well if located within city?
Tract 25, Shallow Water, Ks.

2 WATER WELL OWNER: Beef Belt Feeders
 RR#, St. Address, Box #: R.R. #2 Board of Agriculture, Division of Water Resources
 City, State, ZIP Code: Scott City, Ks. 67871 Application Number: _____

3 LOCATE WELL'S LOCATION WITH AN "X" IN SECTION BOX:

 4 DEPTH OF COMPLETED WELL: 190 ft. ELEVATION: _____
 Depth(s) Groundwater Encountered: 1. _____ ft. 2. _____ ft. 3. _____ ft.
 WELL'S STATIC WATER LEVEL: 108 ft. below land surface measured on mo/day/yr 5-26-89
 Pump test data: Well water was _____ ft. after _____ hours pumping _____ gpm
 Est. Yield: 30 gpm: Well water was _____ ft. after _____ hours pumping _____ gpm
 Bore Hole Diameter: 10 in. to 190 ft., and _____ in. to _____ ft.
 WELL WATER TO BE USED AS:
 Domestic Feedlot 5 Public water supply 8 Air conditioning 11 Injection well
 2 Irrigation 4 Industrial 7 Lawn and garden only 10 Monitoring well stock
 Was a chemical/bacteriological sample submitted to Department? Yes _____ No If yes, mo/day/yr sample was submitted _____
 Water Well Disinfected? Yes No _____

5 TYPE OF BLANK CASING USED:
 1 Steel 3 RMP (SR) 6 Asbestos-Cement 9 Other (specify below) _____
 PVC 4 ABS 7 Fiberglass _____
 Blank casing diameter: 5 in. to 190 ft., Dia. _____ in. to _____ ft., Dia. _____ in. to _____ ft.
 Casing height above land surface: 12 in., weight _____ lbs./ft. Wall thickness or gauge No. 200 psi.
 TYPE OF SCREEN OR PERFORATION MATERIAL:
 PVC 10 Asbestos-cement
 1 Steel 3 Stainless steel 5 Fiberglass 8 RMP (SR) 11 Other (specify) _____
 2 Brass 4 Galvanized steel 6 Concrete tile 9 ABS 12 None used (open hole)
 SCREEN OR PERFORATION OPENINGS ARE:
 5 Gauzed wrapped 11 Saw cut 11 None (open hole)
 1 Continuous slot 3 Mill slot 6 Wire wrapped 9 Drilled holes
 2 Louvered shutter 4 Key punched 7 Torch cut 10 Other (specify) _____
 SCREEN-PERFORATED INTERVALS: From 165 ft. to 190 ft., From _____ ft. to _____ ft.
 GRAVEL PACK INTERVALS: From 25 ft. to 160 ft., From _____ ft. to _____ ft.
 From 170 ft. to 190 ft., From _____ ft. to _____ ft.

6 GROUT MATERIAL: 1 Neat cement Cement grout Bentonite 4 Other _____
 Grout intervals: From 5 ft. to 25 ft., From _____ ft. to _____ ft., From _____ ft. to _____ ft.
 What is the nearest source of possible contamination:
 1 Septic tank 4 Lateral lines 7 Pit privy 10 Livestock pens 14 Abandoned water well
 2 Sewer lines 5 Cess pool 8 Sewage lagoon 11 Fuel storage 15 Oil well/Gas well
 3 Watertight sewer lines 6 Seepage pit 9 Feedyard 12 Fertilizer storage 16 Other (specify below) _____
 13 Insecticide storage _____
 Direction from well? _____ How many feet? 100

FROM	TO	LITHOLOGIC LOG	FROM	TO	PLUGGING INTERVALS
0	1	top soil			
1	21	brown clay			
21	30	coarse sand			
30	61	brown clay			
61	81	fine & coarse sand			
81	110	brown clay			
110	144	gray clay			
144	154	fine sand			
154	161	gray clay			
161	187	fine med. sand some small gravel			
187	189	brown clay			

7 CONTRACTOR'S OR LANDOWNER'S CERTIFICATION: This water well was constructed, (2) reconstructed, or (3) plugged under my jurisdiction and was completed on (mo/day/year) 5-26-89 and this record is true to the best of my knowledge and belief. Kansas Water Well Contractor's License No. 449 This Water Well Record was completed on (mo/day/yr) 6-5-89 under the business name of Midwest Well & Pump by (signature) Arthur Kuhlmann