


1 LOCATION OF WATER WELL: Fraction SW 1/4 NE 1/4 SE 1/4 Section Number 25 Township Number T 19 S Range Number R 33 E

Distance and direction from nearest town or city street address of well if located within city?
 In Shallow Water, Ks.

2 WATER WELL OWNER: Betty Jo Johns
 RR#, St. Address, Box #: 709 Price Board of Agriculture, Division of Water Resources
 City, State, ZIP Code: Garden City, Ks. 67846 Application Number:

3 LOCATE WELL'S LOCATION WITH AN "X" IN SECTION BOX:

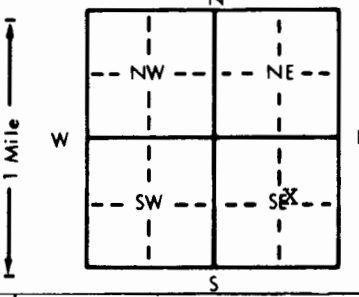

4 DEPTH OF COMPLETED WELL: 190' ft. ELEVATION:
 Depth(s) Groundwater Encountered 1. ft. 2. ft. 3. ft.
 WELL'S STATIC WATER LEVEL: 84' ft. below land surface measured on mo/day/yr 7/3/89
 Pump test data: Well water was ft. after hours pumping gpm
 Est. Yield gpm: Well water was ft. after hours pumping gpm
 Bore Hole Diameter: 9 7/8 in. to 190' ft., and in. to ft.
 WELL WATER TO BE USED AS:
 5 Public water supply 8 Air conditioning 11 Injection well
 1 Domestic 3 Feedlot 6 Oil field water supply 9 Dewatering 12 Other (Specify below)
 2 Irrigation 4 Industrial 7 Lawn and garden only 10 Monitoring well
 Was a chemical/bacteriological sample submitted to Department? Yes No X; If yes, mo/day/yr sample was submitted
 Water Well Disinfected? Yes X No

5 TYPE OF BLANK CASING USED:
 1 Steel 3 RMP (SR) 5 Wrought iron 8 Concrete tile CASING JOINTS: Glued X Clamped
 2 PVC 4 ABS 6 Asbestos-Cement 9 Other (specify below) Welded
 7 Fiberglass Threaded
 Blank casing diameter 5 in. to 190 ft., Dia. in. to ft., Dia. in. to ft.
 Casing height above land surface 12 in., weight 2,902 lbs./ft. Wall thickness or gauge No. 265W
 TYPE OF SCREEN OR PERFORATION MATERIAL:
 1 Steel 3 Stainless steel 5 Fiberglass 7 PVC 10 Asbestos-cement
 2 Brass 4 Galvanized steel 6 Concrete tile 8 RMP (SR) 11 Other (specify)
 12 None used (open hole)
 SCREEN OR PERFORATION OPENINGS ARE:
 1 Continuous slot 3 Mill slot 5 Gauzed wrapped 8 Saw cut 11 None (open hole)
 2 Louvered shutter 4 Key punched 6 Wire wrapped 9 Drilled holes
 7 Torch cut 10 Other (specify)
 SCREEN-PERFORATED INTERVALS: From 170 ft. to 190 ft., From ft. to ft.
 From 145 ft. to 155 ft., From ft. to ft.
 GRAVEL PACK INTERVALS: From 20 ft. to 190 ft., From ft. to ft.
 From ft. to ft., From ft. to ft.

6 GROUT MATERIAL: 1 Neat cement 2 Cement grout 3 Bentonite 4 Other
 Grout Intervals: From 0 ft. to 20 ft., From ft. to ft., From ft. to ft.
 What is the nearest source of possible contamination:
 1 Septic tank 4 Lateral lines 7 Pit privy 10 Livestock pens 14 Abandoned water well
 2 Sewer lines 5 Cess pool 8 Sewage lagoon 11 Fuel storage 15 Oil well/Gas well
 3 Watertight sewer lines 6 Seepage pit 9 Feedyard 12 Fertilizer storage 16 Other (specify below)
 13 Insecticide storage
 Direction from well? Southeast How many feet? 10'

FROM	TO	LITHOLOGIC LOG	FROM	TO	PLUGGING INTERVALS
		See Log Attached,			

7 CONTRACTOR'S OR LANDOWNER'S CERTIFICATION: This water well was (1) constructed, (2) reconstructed, or (3) plugged under my jurisdiction and was completed on (mo/day/year) 6/30/89 and this record is true to the best of my knowledge and belief. Kansas Water Well Contractor's License No. 145 This Water Well Record was completed on (mo/day/yr) 7/7/89 under the business name of Henkle Drilling & Supply Company, Inc. by (signature) *Bruce Richman*

INSTRUCTIONS: Use typewriter or ball point pen. PLEASE PRESS FIRMLY and PRINT clearly. Please fill in blanks, underline or circle the correct answers. Send top three copies to Kansas Department of Health and Environment, Bureau of Water Protection, Topeka, Kansas 66620-7320. Telephone: 913-298-5514. Send one to WATER WELL OWNER and retain one for your records.

OFFICE USE ONLY

DRILLERS TEST LOG

CUSTOMER'S NAME: Betty Jo Johns DATE: 6-29-89
 STREET ADDRESS: 709 Price TEST # 1 E. LOG yes
 CITY & STATE: Garden City, KS 67846 DRILLER Norman
 COUNTY Scott QUARTER SE SECTION 25 TOWNSHIP 19 RANGE 33

LOCATION 10' North west of old well,

%	FOOTAGE			DESCRIPTION OF STRATA	STATIC WATER LEVEL: _____	
	From	Pay	TO		Proposed Well Depth:	
	0		2	Top soil		
	2		76	Brown clay		
	76		90	Sand, fine to medium coarse, small gravel		
	90		106	Gray clay		
	106		123	Blue clay		
40	123	3	126	Sand, fine to medium coarse.		
	126		145	Gray clay		
50	145	12	157	Sand, fine to small, white sand with some clay streaks		
	157		172	Gray clay		
60	172	15	187	White sand from small brown rock		
	187		202	Yellow soap stone		
	202		212	Black shale		
		30				
				TD 190'		
				Perf Plain		
	190		170	20'		
	170		155	15'		
	155		145	10'		
	145		0	145'		
			TOTAL	30'	160'	

GARDEN CITY, KS 67846
 3795 West Jones Ave.

HENKLE DRILLING & SUPPLY CO., INC.
 IRRIGATION HEADQUARTERS

316-277-2389

TEST HOLES * * * * * IRRIGATION & INDUSTRIAL WELLS * * * * * STOCK WELLS