


1 LOCATION OF WATER WELL: Fraction SW SW 1/4 SW 1/4 NE 1/4 Section Number 25 Township Number T 19 S Range Number R 33 E(W)  
 County: Scott

Distance and direction from nearest town or city street address of well if located within city?  
Tract 30 in the township of Shallow Water, Ks. except the north 51' thereof & the south 15' thereof.

2 WATER WELL OWNER: Gary Ludowese Board of Agriculture, Division of Water Resources  
 RR#, St. Address, Box #: Rt. #2 Application Number:  
 City, State, ZIP Code: Shallow Water, Ks. 67871

3 LOCATE WELL'S LOCATION WITH AN "X" IN SECTION BOX:

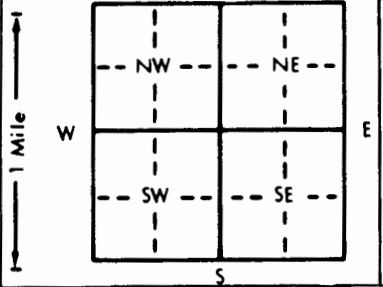

4 DEPTH OF COMPLETED WELL: 192 ft. ELEVATION:  
 Depth(s) Groundwater Encountered 1. .... ft. 2. .... ft. 3. .... ft.  
 WELL'S STATIC WATER LEVEL 110 ft. below land surface measured on mo/day/yr 10-18-91  
 Pump test data: Well water was .... ft. after .... hours pumping .... gpm  
 Est. Yield 20 gpm: Well water was .... ft. after .... hours pumping .... gpm  
 Bore Hole Diameter: 10 in. to 192 ft., and .... in. to .... ft.  
 WELL WATER TO BE USED AS: 5 Public water supply 8 Air conditioning 11 Injection well  
 X Domestic 3 Feedlot 6 Oil field water supply 9 Dewatering 12 Other (Specify below)  
 2 Irrigation 4 Industrial 7 Lawn and garden only 10 Monitoring well  
 Was a chemical/bacteriological sample submitted to Department? Yes..... No X.....; If yes, mo/day/yr sample was submitted  
 Water Well Disinfected? Yes X No

5 TYPE OF BLANK CASING USED: 5 Wrought iron 8 Concrete tile CASING JOINTS: Glued X Clamped  
 1 Steel 3 RMP (SR) 6 Asbestos-Cement 9 Other (specify below) Welded  
 2 PVC 4 ABS 7 Fiberglass Threaded  
 Blank casing diameter 5 in. to 192 ft., Dia. .... in. to .... ft., Dia. .... in. to .... ft.  
 Casing height above land surface 12 in., weight .... lbs./ft. Wall thickness or gauge No. 200 psi  
 TYPE OF SCREEN OR PERFORATION MATERIAL: X PVC 10 Asbestos-cement  
 1 Steel 3 Stainless steel 5 Fiberglass 8 RMP (SR) 11 Other (specify)  
 2 Brass 4 Galvanized steel 6 Concrete tile 9 ABS 12 None used (open hole)  
 SCREEN OR PERFORATION OPENINGS ARE: 5 Gauzed wrapped 8 Saw cut 11 None (open hole)  
 1 Continuous slot 3 Mill slot 6 Wire wrapped 9 Drilled holes  
 2 Louvered shutter 4 Key punched 7 Torch cut 10 Other (specify)  
 SCREEN-PERFORATED INTERVALS: From 144 ft. to 164 ft., From .... ft. to .... ft.  
 From 172 ft. to 192 ft., From .... ft. to .... ft.  
 GRAVEL PACK INTERVALS: From .... ft. to .... ft., From .... ft. to .... ft.  
 From .... ft. to .... ft., From .... ft. to .... ft.

6 GROUT MATERIAL: 1 Neat cement 2 Cement grout X Bentonite 4 Other  
 Grout Intervals: From 5 ft. to 30 ft., From .... ft. to .... ft., From .... ft. to .... ft.  
 What is the nearest source of possible contamination:  
 X Septic tank 4 Lateral lines 7 Pit privy 10 Livestock pens 14 Abandoned water well  
 2 Sewer lines 5 Cess pool 8 Sewage lagoon 11 Fuel storage 15 Oil well/Gas well  
 3 Watertight sewer lines 6 Seepage pit 9 Feedyard 12 Fertilizer storage 16 Other (specify below)  
 13 Insecticide storage  
 Direction from well? How many feet? 100

FROM	TO	LITHOLOGIC LOG	FROM	TO	PLUGGING INTERVALS
0	1	top soil			
1	30	brown clay			
30	32	fine & coarse sand			
32	61	brown clay			
61	81	gray clay			
81	102	fine & coarse sand			
102	147	gray clay			
147	160	fine sand & clay streaks			
160	168	blue clay			
168	178	brown clay			
178	192	fine sand, few clay streaks			

7 CONTRACTOR'S OR LANDOWNER'S CERTIFICATION: This water well was (X) constructed, (2) reconstructed, or (3) plugged under my jurisdiction and was completed on (mo/day/year) 10-18-91 and this record is true to the best of my knowledge and belief. Kansas Water Well Contractor's License No. 532 This Water Well Record was completed on (mo/day/yr) 10-23-91 under the business name of Midwest Well & Pump by (signature) Victor Sankup

OFFICE USE ONLY  
T  
R  
EW  
SEC.  
1/4  
1/4  
1/4