


1 LOCATION OF WATER WELL: County: Scott Fraction SW SW 1/4 SW 1/4 NE 1/4 Section Number 25 Township Number T 19 S Range Number R 33 E W

Distance and direction from nearest town or city street address of well if located within city? Valley township, part of Tract 26, tract beginning 200' west of NE corner of Tract 26 then south 150' then west 157.2' then north 150' then east 157.2' Shallow Water

2 WATER WELL OWNER: Tom Ludowese
 RR#, St. Address, Box # : Shallow Water, Ks. 67871
 City, State, ZIP Code : Shallow Water, Ks. 67871
 Board of Agriculture, Division of Water Resources
 Application Number:

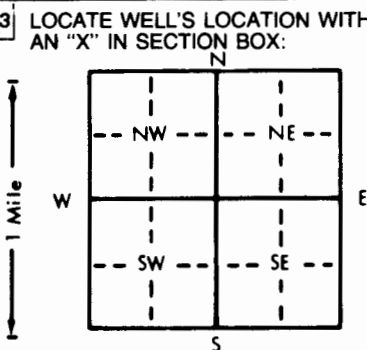

4 DEPTH OF COMPLETED WELL... 180' ft. ELEVATION: ft.
 Depth(s) Groundwater Encountered 1. ft. 2. ft. 3. ft.
 WELL'S STATIC WATER LEVEL... 100 ft. below land surface measured on mo/day/yr... 5-15-92
 Pump test data: Well water was ft. after hours pumping gpm
 Est. Yield... 20 gpm: Well water was ft. after hours pumping gpm
 Bore Hole Diameter... 10 in. to 180 ft., and in. to ft.
 WELL WATER TO BE USED AS:
 Domestic 3 Feedlot 6 Oil field water supply 9 Dewatering 12 Other (Specify below)
 2 Irrigation 4 Industrial 7 Lawn and garden only 10 Monitoring well
 Was a chemical/bacteriological sample submitted to Department? Yes..... No ; If yes, mo/day/yr sample was submitted
 Water Well Disinfected? Yes No

5 TYPE OF BLANK CASING USED:
 1 Steel 3 RMP (SR) 5 Wrought iron 8 Concrete tile CASING JOINTS: Glued... Clamped...
 PVC 4 ABS 6 Asbestos-Cement 9 Other (specify below) Welded...
 7 Fiberglass Threaded...
 Blank casing diameter... 5 in. to 180 ft., Dia... in. to... ft., Dia... in. to... ft.
 Casing height above land surface... 12 in., weight... lbs./ft. Wall thickness or gauge No. 200 psi
 TYPE OF SCREEN OR PERFORATION MATERIAL:
 PVC 10 Asbestos-cement
 1 Steel 3 Stainless steel 5 Fiberglass 8 RMP (SR) 11 Other (specify)
 2 Brass 4 Galvanized steel 6 Concrete tile 9 ABS 12 None used (open hole)
 SCREEN OR PERFORATION OPENINGS ARE:
 1 Continuous slot 3 Mill slot 5 Gauzed wrapped Saw cut 11 None (open hole)
 2 Louvered shutter 4 Key punched 6 Wire wrapped 9 Drilled holes
 7 Torch cut 10 Other (specify)
 SCREEN-PERFORATED INTERVALS: From... 150 ft. to... 180 ft., From... ft. to... ft.
 From... ft. to... ft., From... ft. to... ft.
 GRAVEL PACK INTERVALS: From... 5 ft. to... 140 ft., From... ft. to... ft.
 From... 150 ft. to... 180 ft., From... ft. to... ft.

6 GROUT MATERIAL: 1 Neat cement 2 Cement grout Bentonite hole plug seal 4 Other
 Grout Intervals: From... 5 ft. to... 35 ft., From... ft. to... ft., From... ft. to... ft.
 What is the nearest source of possible contamination:
 Septic tank 4 Lateral lines 7 Pit privy 10 Livestock pens 14 Abandoned water well
 2 Sewer lines 5 Cess pool 8 Sewage lagoon 11 Fuel storage 15 Oil well/Gas well
 3 Watertight sewer lines 6 Seepage pit 9 Feedyard 12 Fertilizer storage 16 Other (specify below)
 13 Insecticide storage
 Direction from well? How many feet? 100

FROM	TO	LITHOLOGIC LOG	FROM	TO	PLUGGING INTERVALS
0	1	top soil			
1	21	brown clay			
21	29	fine & coarse sand			
29	56	brown clay			
56	70	fine & medium sand			
70	111	brown clay			
111	122	blue clay			
122	152	brown clay			
152	162	fine sand, few clay streaks			
162	166	brown clay			
166	176	fine & medium sand			
176	178	brown clay			
178	180	yellow clay			

7 CONTRACTOR'S OR LANDOWNER'S CERTIFICATION: This water well was (constructed, (2) reconstructed, or (3) plugged under my jurisdiction and was completed on (mo/day/year) ... 5-15-92 ... and this record is true to the best of my knowledge and belief. Kansas Water Well Contractor's License No. 532 This Water Well Record was completed on (mo/day/yr) ... 5-18-92 ... under the business name of Midwest Well & Pump by (signature) Victor Sankoff

OFFICE USE ONLY T R EW SEC 1/4 1/4 1/4