


WATER WELL RECORD Form WWC-5 KSA 82a-1212

1 LOCATION OF WATER WELL: ; Fraction ; Section Number ; Township Number ; Range Number  
 COUNTY: 086 SCOTT ; NW 1/4 NW 1/4 NE 1/4 ; 23 ; T 19 S ; R 33 W

Distance and direction from nearest town or city street address of well if located within city?  
 APPROX. 1 MILE NORTH AND 1 MILE WEST OF SHALLOW WATER.

2 WATER WELL OWNER: CLAWSON  
 RR#, St. Address, Box #: RT. 1, BOX 65F Board of Agriculture, Division of Water Resources  
 City, State, ZIP code: SATANTA, KS 67870- Application Number: 27,980

3 LOCATE WELL'S LOCATION WITH AN "X" IN SECTION BOX: ; 4 DEPTH OF COMPLETED WELL 205 ELEVATION: 0  
 Depth(s) Groundwater Encountered 1. 0 ft. 2. 0 ft. 3. 0 ft.

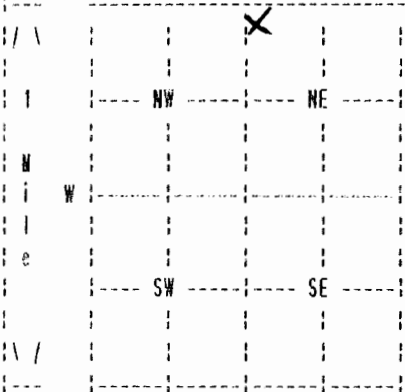

WELL'S STATIC WATER LEVEL 119 ft. below land surface measured on mo/day/yr 01/17/95  
 Pump test data: Well water was 145 ft. after 2 hours pumping 670 gpm  
 Estimated Yield 670 gpm; Well water was 0 ft. after 0 hours pumping 0 gpm  
 Bore Hole Diameter 24 in. to 205 ft., and in. to 0 ft.  
 WELL WATER TO BE USED AS: 02 IRRIGATION  
 Was a chemical/bacteriological sample submitted to department? No ;  
 If yes, mo/day/yr sample was submitted Water well disinfected? Yes ;

5 TYPE OF BLANK CASING USED: 01 STEEL CASING JOINTS: WELDED  
 Blank casing diameter 16 in. to 205 ft., Dia in. to 0 ft., Dia in. to 0 ft.  
 Casing height above land surface 12 in., weight 42 lbs/ft. Wall thickness or gauge No. .250  
 TYPE OF SCREEN OR PERFORATION MATERIAL: 01 STEEL  
 SCREEN OR PERFORATION OPENINGS ARE: 01 CONT. SLOT

SCREEN PERFORATED INTERVALS: From 145 ft. to 195 ft., From 0 ft. to 0 ft.  
 From 0 ft. to 0 ft., From 0 ft. to 0 ft.  
 GRAVEL PACK INTERVALS: From 20 ft. to 205 ft., From 0 ft. to 0 ft.  
 From 0 ft. to 0 ft., From 0 ft. to 0 ft.

6 GROUT MATERIAL 03 BENTONITE  
 Grout Intervals: From 0 ft. to 20 ft., From 0 ft. to 0 ft., From 0 ft. to 0 ft.  
 What is the nearest source of possible contamination: 14 ABAND. WELL  
 Direction from well? SOUTHEAST How many feet? 45

FROM	TO	LITHOLOGIC LOG	FROM	TO	PLUGGING INTERVALS
0	3	02 SILT			
3	7	03 SILTY CLAY			
7	43	01 CLAY			
43	54	07 FINE SAND 09 COARSE SAND 13 FINE GRAVEL			
54	59	01 CLAY			
59	75	07 FINE SAND 09 COARSE SAND 13 FINE GRAVEL			
75	78	01 CLAY			
78	95	07 FINE SAND 08 MEDIUM SAND 04 SANDY CLAY			
95	98	01 CLAY			
98	118	07 FINE SAND 09 COARSE SAND 13 FINE GRAVEL			

7 CONTRACTOR'S OR LANDOWNER'S CERTIFICATION: This water well was Constructed under my jurisdiction and was completed on (mo/day/year) 01/13/95 and this record is true to the best of my knowledge and belief. Kansas Water Well Contractor's License No. 145 This Water Well Record was completed on (mo/day/yr) 01/20/95 under the business name of HEMKLE DRILLING & SUPPLY by (signature)

