

#30


Plugging Report

1 LOCATION OF WATER WELL: County: SCOTT Fraction: NW 1/4 SW 1/4 SE 1/4 Section Number: 28 Township Number: T 19 S Range Number: R 34 E/W

Distance and direction from nearest town or city street address of well if located within city? From Scott city 9 South 8 1/2 West 1/8 North

2 WATER WELL OWNER: SD BONTANGEN NON-MARITAL TRUST % KATIE BONTANGEN Trustee RR#, St. Address, Box #: 705 ADA SCOTT city KS 67871 Board of Agriculture, Division of Water Resources Application Number: VR 25315

3 LOCATE WELL'S LOCATION WITH AN "X" IN SECTION BOX:

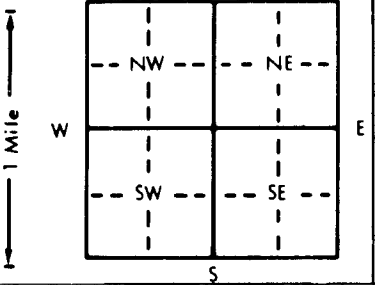

4 DEPTH OF COMPLETED WELL: 130 ft. ELEVATION: Depth(s) Groundwater Encountered 1. 124 ft. 2. 90 ft. 3. WELL'S STATIC WATER LEVEL 124 ft. below land surface measured on mo/day/yr 9-21-90 Pump test data: Well water was ... ft. after ... hours pumping ... gpm Est. Yield ... gpm: Well water was ... ft. after ... hours pumping ... gpm Bore Hole Diameter ... in. to ... ft., and ... in. to ... ft. WELL WATER TO BE USED AS: 5 Public water supply 8 Air conditioning 11 Injection well 1 Domestic 3 Feedlot 6 Oil field water supply 9 Dewatering 12 Other (Specify below) Irrigation 4 Industrial 7 Lawn and garden only 10 Monitoring well Was a chemical/bacteriological sample submitted to Department? Yes ... No ... If yes, mo/day/yr sample was submitted Water Well Disinfected? Yes No

5 TYPE OF BLANK CASING USED: 1 Steel 3 RMP (SR) 5 Wrought iron 8 Concrete tile CASING JOINTS: Glued Clamped 2 Brass 4 Galvanized steel 6 Asbestos-Cement 9 Other (specify below) Welded 3 Watertight sewer lines 6 Seepage pit 7 Fiberglass Threaded 4 ABS

Blank casing diameter ... in. to ... ft., Dia ... in. to ... ft., Dia ... in. to ... ft. Casing height above land surface ... 3 below in., weight ... lbs./ft. Wall thickness or gauge No. ...

TYPE OF SCREEN OR PERFORATION MATERIAL: 1 Steel 3 Stainless steel 5 Fiberglass 8 RMP (SR) 10 Asbestos-cement 2 Brass 4 Galvanized steel 6 Concrete tile 9 ABS 11 Other (specify) 12 None used (open hole)

SCREEN OR PERFORATION OPENINGS ARE: 1 Continuous slot 3 Mill slot 5 Gauzed wrapped 8 Saw cut 11 None (open hole) 2 Louvered shutter 4 Key punched 6 Wire wrapped 9 Drilled holes 7 Torch cut 10 Other (specify)

SCREEN-PERFORATED INTERVALS: From ... ft. to ... ft., From ... ft. to ... ft. GRAVEL PACK INTERVALS: From ... ft. to ... ft., From ... ft. to ... ft.

6 GROUT MATERIAL: 1 Neat cement 3 Bentonite 4 Other Grout Intervals: From ... 6 ft. to ... 3 ft., From ... ft. to ... ft., From ... ft. to ... ft.

What is the nearest source of possible contamination: 1 Septic tank 4 Lateral lines 7 Pit privy 10 Livestock pens 14 Abandoned water well 2 Sewer lines 5 Cess pool 8 Sewage lagoon 11 Fuel storage 15 Oil well/Gas well 3 Watertight sewer lines 6 Seepage pit Feedyard 12 Fertilizer storage 16 Other (specify below) 13 Insecticide storage

Direction from well? NE How many feet? OVER 5 miles

Table with columns: FROM, TO, LITHOLOGIC LOG, FROM, TO, PLUGGING INTERVALS. Row 1: 130, 124, Sand & Gravel 281 Cu FT, FROM, TO, PLUGGING INTERVALS. Row 2: 124, 03, Cement Grout 16.5 Cu FT, FROM, TO, PLUGGING INTERVALS.

7 CONTRACTOR'S OR LANDOWNER'S CERTIFICATION: This water well was (1) constructed, (2) reconstructed, or (3) plugged under my jurisdiction and was completed on (mo/day/year) 9-21-90 and this record is true to the best of my knowledge and belief. Kansas Water Well Contractor's License No. 145 This Water Well Record was completed on (mo/day/yr) under the business name of Hankle Drilling & Supply Co by (signature) Don Paulson

OFFICE USE ONLY T R E/W SEC 1/4 1/4 1/4