


1 LOCATION OF WATER WELL:	Fraction County: Wichita NE 1/4 NE 1/4 NE 1/4	Section Number 32	Township Number T 19 S	Range Number R 37 EW
---------------------------	--	----------------------	---------------------------	-------------------------

Distance and direction from nearest town or city street address of well if located within city?

3 1/2 miles West 8 miles South of Leoti, Kansas

2 WATER WELL OWNER:	Charlie Carpenter	RR# St. Address, Box # : RFD	Board of Agriculture, Division of Water Resources
City, State, ZIP Code :	Leoti, Kansas 67861	Application Number:	

3 LOCATE WELL'S LOCATION WITH AN "X" IN SECTION BOX:	4 DEPTH OF COMPLETED WELL .120 ft. ELEVATION:
--	---

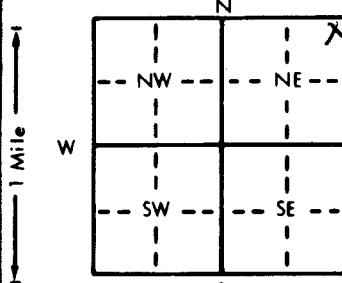

Depth(s) Groundwater Encountered 1 .92 ft. 2 ft. 3 ft.

WELL'S STATIC WATER LEVEL .92 ft. below land surface measured on mo/day/yr 7/15/83

Pump test data: Well water was ft. after hours pumping gpm

Est. Yield gpm: Well water was ft. after hours pumping gpm

Bore Hole Diameter 9 in. to .120 ft. and in. to ft.

WELL WATER TO BE USED AS: 5 Public water supply 8 Air conditioning 11 Injection well

1 Domestic 3 Feedlot 6 Oil field water supply 9 Dewatering 12 Other (Specify below)

2 Irrigation 4 Industrial 7 Lawn and garden only 10 Observation well

Was a chemical/bacteriological sample submitted to Department? Yes No X If yes, mo/day/yr sample was submitted

Water Well Disinfected? Yes X No

5 TYPE OF BLANK CASING USED:	5 Wrought iron	8 Concrete tile	CASING JOINTS: Glued Clamped
1 Steel	6 Asbestos-Cement	9 Other (specify below)	Welded
2 PVC	7 Fiberglass		Threaded

Blank casing diameter 5 in. to .100 ft., Dia in. to ft., Dia in. to ft.

Casing height above land surface 12 in., weight 2.9 lbs./ft. Wall thickness or gauge No. .265

TYPE OF SCREEN OR PERFORATION MATERIAL:	7 PVC	10 Asbestos-cement
1 Steel	8 RMP (SR)	11 Other (specify)
2 Brass	9 ABS	12 None used (open hole)

SCREEN OR PERFORATION OPENINGS ARE:

1 Continuous slot	3 Mill slot	5 Gauzed wrapped	7 PVC	10 Asbestos-cement
2 Louvered shutter	4 Key punched	6 Wire wrapped	8 RMP (SR)	11 Other (specify)
		7 Torch cut	9 ABS	12 None used (open hole)

SCREEN-PERFORATED INTERVALS: From 100 ft. to .120 ft., From ft. to ft.

From ft. to ft., From ft. to ft.

GRAVEL PACK INTERVALS: From 80 ft. to .120 ft., From ft. to ft.

From ft. to ft., From ft. to ft.

6 GROUT MATERIAL:	1 Neat cement	2 Cement grout	3 Bentonite	4 Other	Drill cuttings
-------------------	---------------	----------------	-------------	---------	--------------------------

Grout Intervals: From 15 ft. to .80 ft., From 4 ft. to 15 ft., From ft. to ft.

What is the nearest source of possible contamination:

1 Septic tank	4 Lateral lines	7 Pit privy	10 Livestock pens	14 Abandoned water well
2 Sewer lines	5 Cess pool	8 Sewage lagoon	11 Fuel storage	15 Oil well/Gas well
3 Watertight sewer lines	6 Seepage pit	9 Feedyard	12 Fertilizer storage	16 Other (specify below)

Direction from well? East How many feet? 100

FROM	TO	LITHOLOGIC LOG	FROM	TO	LITHOLOGIC LOG
------	----	----------------	------	----	----------------

0	24	Clay	24	32	Rock
32	44	Clay	44	48	Sand fine
48	52	Sand rock	52	117	Sand
117	120	Yellow clay			

7 CONTRACTOR'S OR LANDOWNER'S CERTIFICATION: This water well was (1) constructed, (2) reconstructed, or (3) plugged under my jurisdiction and was completed on (mo/day/year) 7/26/83 and this record is true to the best of my knowledge and belief. Kansas

Water Well Contractor's License No. 232 This Water Well Record was completed on (mo/day/year) 7/26/83

under the business name of Meishaar Drilling & Supply Inc. by (signature) Paul Stanton

INSTRUCTIONS: Use typewriter or ball point pen, PLEASE PRESS FIRMLY and PRINT clearly. Please fill in blanks, underline or circle the correct answers. Send top three copies to Kansas Department of Health and Environment, Division of Environment, Environmental Geology Section, Topeka, KS 66620. Send one to WATER WELL OWNER and retain one for your records.