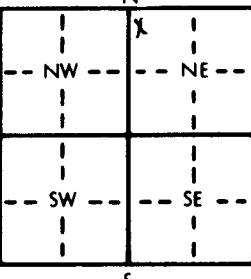
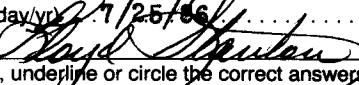


1 LOCATION OF WATER WELL:		Fraction NW 1/4 NW 1/4 NE 1/4	Section Number 29	Township Number T 19 S	Range Number R 38 E (W)		
Distance and direction from nearest town or city street address of well if located within city? 6 1/2 miles South 1/2 mile East of Selkirk, Kansas							
2 WATER WELL OWNER:		Glenn Burch Rfd # 2 Box 159 Leoti, Kansas 67861		Board of Agriculture, Division of Water Resources Application Number:			
3 LOCATE WELL'S LOCATION WITH AN "X" IN SECTION BOX:		 4 DEPTH OF COMPLETED WELL 150 ft. ELEVATION: Depth(s) Groundwater Encountered 1 112 ft. 2 ft. 3 ft. WELL'S STATIC WATER LEVEL 112 ft. below land surface measured on mo/day/yr 7/14/86 Pump test data: Well water was ft. after hours pumping gpm Est. Yield gpm: Well water was ft. after hours pumping gpm Bore Hole Diameter 9 in. to 150 ft. and in. to ft. WELL WATER TO BE USED AS: 5 Public water supply 8 Air conditioning 11 Injection well 1 Domestic 3 Feedlot 6 Oil field water supply 9 Dewatering 12 Other (Specify below) 2 Irrigation 4 Industrial 7 Lawn and garden only 10 Observation well Was a chemical/bacteriological sample submitted to Department? Yes No X If yes, mo/day/yr sample was submitted Water Well Disinfected? Yes X No					
5 TYPE OF BLANK CASING USED:		5 Wrought iron 1 Steel 2 PVC	6 Asbestos-Cement 3 RMP (SR) 4 ABS	8 Concrete tile 9 Other (specify below)	CASING JOINTS: Glued Clamped Welded Threaded		
Blank casing diameter 5 in. to 130 ft., Dia in. to ft., Dia in. to ft.							
Casing height above land surface 12 in., weight 2.9 lbs./ft. Wall thickness or gauge No. 265							
TYPE OF SCREEN OR PERFORATION MATERIAL:							
1 Steel 2 Brass	3 Stainless steel 4 Galvanized steel	5 Fiberglass 6 Concrete tile	7 PVC 8 RMP (SR) 9 ABS	10 Asbestos-cement 11 Other (specify) 12 None used (open hole) 13 Saw cut 9 Drilled holes 10 Other (specify) 11 None (open hole)			
SCREEN OR PERFORATION OPENINGS ARE:							
1 Continuous slot 2 Louvered shutter	3 Mill slot 4 Key punched	5 Gauzed wrapped 6 Wire wrapped 7 Torch cut	8 Saw cut 9 Drilled holes 10 Other (specify)				
SCREEN-PERFORATED INTERVALS: From 130 ft. to 150 ft., From ft. to ft.							
From ft. to ft., From ft. to ft.							
GRAVEL PACK INTERVALS: From 100 ft. to 150 ft., From ft. to ft.							
From ft. to ft., From ft. to ft.							
6 GROUT MATERIAL: 1 Neat cement 2 Cement grout 3 Bentonite 4 Other Drill. cuttings							
Grout Intervals: From 15 ft. to 100 ft., From 4 ft. to 15 ft., From ft. to ft.							
What is the nearest source of possible contamination:							
1 Septic tank 2 Sewer lines 3 Watertight sewer lines	4 Lateral lines 5 Cess pool 6 Seepage pit	7 Pit privy 8 Sewage lagoon 9 Feedyard	10 Livestock pens 11 Fuel storage 12 Fertilizer storage 13 Insecticide storage	14 Abandoned water well 15 Oil well/Gas well 16 Other (specify below)			
Direction from well? Southeast How many feet? 100							
FROM	TO	LITHOLOGIC LOG		FROM	TO	LITHOLOGIC LOG	
0	17	Clay		17	21	Caliche	
17	24	Sand		24	31	Clay	
31	45	Fine sand clay streaks		45	68	Sand	
68	70	Sand cemented		70	72	Clay	
72	83	Sand cemented		83	100	Clay	
100	115	Fine sand clay streaks		115	145	Sand	
145	150	Clay					
7 CONTRACTOR'S OR LANDOWNER'S CERTIFICATION: This water well was (1) constructed (2) reconstructed, or (3) plugged under my jurisdiction and was completed on (mo/day/year) 7/14/86 and this record is true to the best of my knowledge and belief. Kansas							
INSTRUCTIONS: Use typewriter or ball point pen, PLEASE PRESS FIRMLY and PRINT clearly. Please fill in blanks, underline or circle the correct answers. Send top three copies to Kansas Department of Health and Environment, Division of Environment, Environmental Geology Section, Topeka, KS 66620. Send one to WATER WELL OWNER and retain one for your records.							