

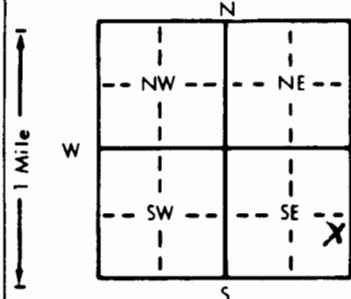
1 LOCATION OF WATER WELL:	Fraction	Section Number	Township Number	Range Number
County: <u>McPherson</u>	<u>NE 1/4 SE 1/4 SE 1/4</u>	<u>29</u>	T <u>19</u> S	R <u>4</u> EW

Distance and direction from nearest town or city street address of well if located within city?

1/2 Mile East and 3/8 Mile South of Conway, KS

2 WATER WELL OWNER:	Board of Agriculture, Division of Water Resources
RR#, St. Address, Box #:	Application Number:
City, State, ZIP Code:	

3 LOCATE WELL'S LOCATION WITH AN "X" IN SECTION BOX:	4 DEPTH OF COMPLETED WELL: <u>55.5</u> ft. ELEVATION: <u>—</u>
--	--

Depth(s) Groundwater Encountered 1. 30' ft. 2. — ft. 3. — ft.WELL'S STATIC WATER LEVEL 34.64 ft. below land surface measured on mo/day/yr 10/2/96Pump test data: Well water was — ft. after — hours pumping — gpmEst. Yield — gpm; Well water was — ft. after — hours pumping — gpmBore Hole Diameter 6 in. to 55.5 ft., and — in. to — ft.

WELL WATER TO BE USED AS:

1 Domestic 3 Feedlot 6 Oil field water supply 9 Dewatering 12 Other (Specify below)

2 Irrigation 4 Industrial 7 Lawn and garden only 10 Monitoring well MW-TX-42Was a chemical/bacteriological sample submitted to Department? Yes — No X; If yes, mo/day/yr sample was sub-

mitted

Water Well Disinfected? Yes — No X

5 TYPE OF BLANK CASING USED:	5 Wrought iron	8 Concrete tile	CASING JOINTS: Glued <u>—</u> Clamped <u>—</u>
------------------------------	----------------	-----------------	--

1 Steel 3 RMP (SR) 6 Asbestos-Cement 9 Other (specify below) Welded —2 PVC 4 ABS 7 Fiberglass 7 PVC Threaded XBlank casing diameter 2 1/2 in. to 35 ft., Dia — in. to — ft., Dia — in. to — ft.Casing height above land surface 2.5 in., weight — lbs./ft. Wall thickness or gauge No. Sh 40

TYPE OF SCREEN OR PERFORATION MATERIAL:

1 Steel 3 Stainless steel 5 Fiberglass 8 RMP (SR) 11 Other (specify) —

2 Brass 4 Galvanized steel 6 Concrete tile 9 ABS 12 None used (open hole)

SCREEN OR PERFORATION OPENINGS ARE:

1 Continuous slot 3 Mill slot 5 Gauzed wrapped 8 Saw cut 11 None (open hole)

2 Louvered shutter 4 Key punched 6 Wire wrapped 9 Drilled holes

SCREEN-PERFORATED INTERVALS: From 35 ft. to 55 ft., From — ft. to — ft.From — ft. to — ft., From — ft. to — ft.GRAVEL PACK INTERVALS: From 33 ft. to 55.5 ft., From — ft. to — ft.From — ft. to — ft., From — ft. to — ft.6 GROUT MATERIAL: 1 Neat cement 2 Cement grout 3 Bentonite 4 Other —Grout Intervals: From 1 ft. to 33 ft., From — ft. to — ft., From — ft. to — ft.

What is the nearest source of possible contamination:

1 Septic tank 4 Lateral lines 7 Pit privy 10 Livestock pens 14 Abandoned water well

2 Sewer lines 5 Cess pool 8 Sewage lagoon 11 Fuel storage 15 Oil well/Gas well

3 Watertight sewer lines 6 Seepage pit 9 Feedyard 12 Fertilizer storage 16 Other (specify below)

Direction from well? NW How many feet? 50'

FROM TO LITHOLOGICAL LOG FROM TO PLUGGING INTERVALS

0 15' Sand + gravel fill.5 3' Clay, Brown3' 9' Clay, Lt. Red Brown9' 11' Weathered Shale, red Brown11' 55.5' Shale, red brown w/ bluegray lenses