

1 LOCATION OF WATER WELL: County: McPherson	Fraction SE ¼ SE ¼ NE ¼	Section Number 30	Township Number T 19 S	Range Number R 4 E
---	-----------------------------------	-----------------------------	----------------------------------	------------------------------

Distance and direction from nearest town or city street address of well if located within city?

Approx 6 miles West of McPherson on US Hwy 56

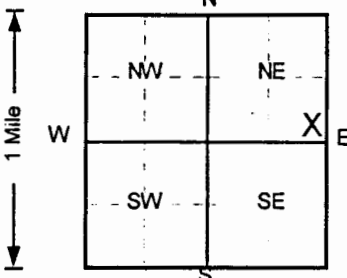
2 WATER WELL OWNER: **Texaco Natural Gas Liquids**RR#, St. Address, Box # : **661 Hwy 56**City, State, ZIP Code : **McPherson, Kansas 67460**

Board of Agriculture, Division of Water Resources

Application Number:

3 LOCATE WELL'S LOCATION
WITH AN "X" IN SECTION BOX:

N

4 DEPTH OF COMPLETED WELL **79.5** ft ELEVATION: **999**Depth(s) Groundwater Encountered 1. **999** ft 2. ft 3. ftWELL'S STATIC WATER LEVEL ... **22.2** ... ft below land surface measured on mo/day/yr ... **1/24/97**Pump test data: Well water was ... **NA** ... ft after hours pumping gpmEst. Yield ... **NA** ... gpm: Well water was ft after hours pumping gpmBore Hole Diameter ... **10** ... in. to ... **30** ... ft, and ... **6** ... in. to ... **100** ... ft

WELL WATER TO BE USED AS: 5 Public water supply 8 Air conditioning 11 Injection well

1 Domestic 3 Feedlot 6 Oil field water supply 9 Dewatering 12 Other (Specify below)

2 Irrigation 4 Industrial 7 Lawn and garden only **10** Monitoring wellWas a chemical/bacteriological sample submitted to Department? Yes.....No ☒; If yes, mo/day/yr sample was submittedWater Well Disinfected? Yes No ☒

5 TYPE OF BLANK CASING USED:

5 Wrought iron

8 Concrete tile

CASING JOINTS: Glued Clamped

1 Steel

3 RMP (SR)

6 Asbestos-Cement

9 Other (specify below)

Welded

2 PVC

4 ABS

7 Fiberglass

Threaded. ☒Blank casing diameter ... **6** Steel ... in. to ... **30** ... ft, Dia ... **2** PVC ... in. to ... **69.5** ... ft, Dia in. to ftCasing height above land surface **30** in., weight lbs./ft. Wall thickness or gauge No. **Sch. 40**

TYPE OF SCREEN OR PERFORATION MATERIAL

1 Steel

3 Stainless steel

5 Fiberglass

7 PVC

10 Asbestos-cement

2 Brass

4 Galvanized steel

6 Concrete tile

8 RMP (SR)

11 Other (specify)

12 None used (open hole)

SCREEN OR PERFORATION OPENINGS ARE:

1 Continuous slot

3 Mill slot

5 Gauzed wrapped

8 Saw cut

11 None (open hole)

2 Louvered shutter

4 Key punched

6 Wire wrapped

9 Drilled holes

7 Torch cut

10 Other (specify)

SCREEN-PERFORATED INTERVALS: From **69.5** ft to **79.5** ft, From ft to ft

From ft to ft, From ft to ft

GRAVEL PACK INTERVALS: From **65** ft to **82** ft, From ft to ft

From ft to ft, From ft to ft

6 GROUT MATERIAL:

1 Neat cement

2 Cement grout**3** Bentonite

4 Other

Grout intervals: From **0** ft to **30** ft, From **0** ft to **65** ft, From **82** ft to **100** ft

What is the nearest source of possible contamination:

1 Septic tank

4 Lateral lines

7 Pit privy

10 Livestock pens

14 Abandoned water well

2 Sewer lines

5 Cess pool

8 Sewage lagoon

11 Fuel storage

15 Oil well/Gas well

3 Watertight sewer lines

6 Seepage pit

9 Feedyard

12 Fertilizer storage

16 Other (specify below)

13 Insecticide storage

Gas Storage Field ...

Direction from well?

How many feet?

FROM	TO	LITHOLOGIC LOG	FROM	TO	PLUGGING INTERVALS
0	0.5	Clay, Black			
0.5	11.5	Clay, Grayish Brown			
11.5	15	Clay, Reddish Brown			
15	30	Weathered shale/silt, Dark Red Brown			
30	51	Shale, Red, Gray, Green			
51	56	Shale, Green, Limey			
56	72	Shale, Red, Gray, Green			
72	74	Shale, Green, Limey			
74	78	Shale, Red, Gray, Green			
78	88	Shale, Red, Brown, Limey, Gypsum			
88	96	Shale, Red, Gray			
96	98	Shale, Gray, Red, Gypsum			
98	100	Shale, Red, Gray			
					CI-TEX1-deep, Abovegrade
					Project Name: Wilson and Company-Conway
					GeoCore # 452, Wilson and Co. # 9342005002

7 CONTRACTOR'S OR LANDOWNER'S CERTIFICATION: This water well was **(1)** constructed, (2) reconstructed, or (3) plugged under my jurisdictionand was completed on (mo/day/year) **1/29/97** and this record is true to the best of my knowledge and belief.Kansas Water Well Contractor's License No. **527** This Water Well Record was completed on (mo/day/yr) **2/20/97**

under the business name of

GeoCore Services, Inc.

by (signature)

Dick A. Bell