


1) LOCATION OF WATER WELL:	Fraction	Section Number	Township Number	Range Number
County: McPherson	NE ¼ SE ¼ SW ¼	28	T 19 S	R 4 E (W)

Approx 6 miles West of McPherson on US Hwy 56

Board of Agriculture, Division of Water Resources
Application Number:

4) DEPTH OF COMPLETED WELL 42 ft		ELEVATION: 999	
Depth(s) Groundwater Encountered 1. 999 ft		2. ft 3. ft	
WELL'S STATIC WATER LEVEL 28.4 ft		below land surface measured on mo/day/yr 1/24/97	
Pump test data: Well water was NA ft		after hours pumping gpm	
Est Yield NA gpm: Well water was ft		after hours pumping gpm	
Bore Hole Diameter 8 in.		to 42.5 ft, and in. to ft	
WELL WATER TO BE USED AS:			
5 Public water supply		8 Air conditioning	
11 Injection well			
1 Domestic		3 Feedlot	
6 Oil field water supply		9 Dewatering	
12 Other (Specify below)			
2 Irrigation		4 Industrial	
7 Lawn and garden only		10 Monitoring well	
Was a chemical/bacteriological sample submitted to Department? Yes.....No✓.....; If yes, mo/day/yr sample was submitted			
Water Well Disinfected? Yes No✓			

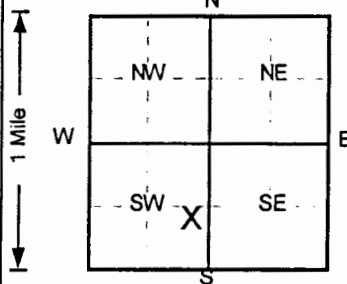

Blank Casing diameter 2 in. to 22 ft, Dia in. to ft, Dia in. to ft
Casing height above land surface 24 in. weight lbs./ft. Wall thickness or gauge No. Sch. 40

1 Steel	3 Stainless steel	5 Fiberglass	8 RMP (SR)	11 Other (specify)
2 Brass	4 Galvanized steel	6 Concrete tile	9 ABS	12 None used (open hole)

1 Continuous slot **3** Mill slot 6 Wire wrapped 9 Drilled holes
2 Louvered shutter 4 Key punched 7 Torch cut 10 Other (specify)

SCREEN-PERFORATED INTERVALS: From 22 ft to 42 ft, From ft to ft
From ft to ft, From ft to ft
GRAVEL PACK INTERVALS: From 16 ft to 42 ft, From ft to ft
From ft to ft, From ft to ft

6	GROUT MATERIAL:	1 Neat cement	2 Cement grout	3 Bentonite	4 Other
	Grout Intervals:	From 0 ft to 13 ft	From 13 ft to 16 ft	From ft to ft	From ft to ft

1 Septic tank	4 Lateral lines	7 Pit privy	11 Fuel storage	15 Oil well/Gas well
2 Sewer lines	5 Cess pool	8 Sewage lagoon	12 Fertilizer storage	16 Other (specify below)
3 Watertight sewer lines	6 Seepage pit	9 Feedyard	13 Insecticide storage	Gas Storage Field ...

Direction from well?

FROM	TO	LITHOLOGIC LOG	FROM	TO	PLUGGING INTERVALS
0	7.5	Clay, Dark Reddish Brown			
7.5	10	Clay, Brown			
10	15	Silt, Brown			
15	21	Silt, Tannish Brown			
21	32.5	Clay, Brown			
32.5	39	Clay, Reddish Brown			
39	42.5	Weathered Shale/Silt, Dark Reddish Brown			
					CI-KOCH1-shallow , Abovegrade
					Project Name: Wilson and Company-Conway
					GeoCore # 452 , Wilson and Co. # 9342005002

7 CONTRACTOR'S OR LANDOWNER'S CERTIFICATION: This water well was (1) constructed, (2) reconstructed, or (3) plugged under my jurisdiction and was completed on (mo/day/year) 1/29/97 and this record is true to the best of my knowledge and belief.
Kansas Water Well Contractor's License No. 527 This Water Well Record was completed on (mo/day/yr) 2/20/97
under the business name of **GeoCore Services, Inc.** by (signature) *Dee Hill*

INSTRUCTIONS: Use typewriter or ball point pen. **PLEASE PRESS FIRMLY** and **PRINT** clearly. Please fill in blanks, underline or circle the correct answers. Send top three copies to Kansas Department of Health and Environment, Bureau of Water, Topeka, Kansas 66620-0001. Telephone: 913-296-5545. Send one to **WATER WELL OWNER** and retain one for your records.