


027148

1 LOCATION OF WATER WELL: Fraction SW 1/4 NE 1/4 NW 1/4 Section Number 29 Township Number T 19 S Range Number R 4 NW

County: McPherson
 Distance and direction from nearest town or city street address of well if located within city?
~ 0.5 mile W of Conway, N of Hwy 56

2 WATER WELL OWNER: Williams midstream Natural Gas Liquids Inc.
 RR#, St. Address, Box #: 1426 Sth Ave Board of Agriculture, Division of Water Resources
 City, State, ZIP Code: McPherson KS 67460 Application Number:

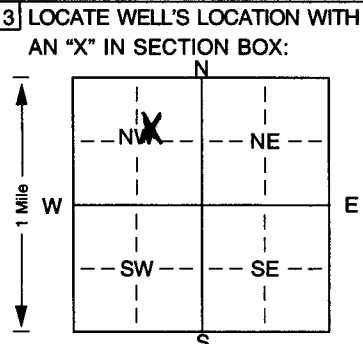

4 DEPTH OF COMPLETED WELL: 15.2 ft. ELEVATION:

Depth(s) Groundwater Encountered 1. ft. 2. ft. 3. ft.

WELL'S STATIC WATER LEVEL ft. below land surface measured on mo/day/yr

Pump test data: Well water was ft. after hours pumping gpm

Est. Yield gpm: Well water was ft. after hours pumping gpm

Bore Hole Diameter: 8.5 in. to 15.2 ft., and in. to ft.

WELL WATER TO BE USED AS:

5 Public water supply	8 Air conditioning	11 Injection well
1 Domestic	3 Feedlot	6 Oil field water supply
2 Irrigation	4 Industrial	7 Domestic (lawn & garden)
		9 Dewatering
		10 Monitoring well
		12 Other (specify below)

Was a chemical/bacteriological sample submitted to Department? Yes. No. X; If yes, mo/day/yr sample was submitted

Water Well Disinfected? Yes No X

5 TYPE OF BLANK CASING USED:

1 Steel	3 RMP (SR)	5 Wrought iron	8 Concrete tile	CASING JOINTS: Glued. Clamped.
<u>2 PVC</u>	4 ABS	6 Asbestos-Cement	9 Other (specify below)	Welded.
		7 Fiberglass		<u>Threaded</u> <u>Flush</u>

Blank casing diameter 2 in. to 5 ft., Dia in. to ft., Dia in. to ft.

Casing height above land surface ~42 in., weight 705 lbs./ft. Wall thickness or gauge No. Sch 40

TYPE OF SCREEN OR PERFORATION MATERIAL:

1 Steel	3 Stainless steel	5 Fiberglass	7 PVC	10 Asbestos-cement
2 Brass	4 Galvanized steel	6 Concrete tile	8 RMP (SR)	11 Other (specify)
			9 ABS	12 None used (open hole)

SCREEN OR PERFORATION OPENINGS ARE:

1 Continuous slot	3 Mill slot	5 Gauzed wrapped	8 Saw cut	11 None (open hole)
2 Louvered shutter	4 Key punched	6 Wire wrapped	9 Drilled holes	
		7 Torch cut	10 Other (specify) ft.	

SCREEN-PERFORATED INTERVALS: From 5 ft. to 15 ft., From ft. to ft.

GRAVEL PACK INTERVALS: From 3 ft. to 15.2 ft., From ft. to ft.

6 GROUT MATERIAL: 1 Neat cement 2 Cement grout 3 Bentonite 4 Other Concrete

Grout Intervals: From 0 ft. to 1 ft., From 1 ft. to 3 ft., From ft. to ft.

What is the nearest source of possible contamination:

1 Septic tank	4 Lateral lines	7 Pit privy	10 Livestock pens	14 Abandoned water well
2 Sewer lines	5 Cess pool	8 Sewage lagoon	11 Fuel storage	15 Oil well/Gas well
3 Watertight sewer lines	6 Seepage pit	9 Feedyard	12 Fertilizer storage	16 Other (specify below)
			13 Insecticide storage	

Direction from well? How many feet?

FROM	TO	LITHOLOGIC LOG	FROM	TO	PLUGGING INTERVALS
0	10.2	Silty clay, dk br			
10.2	12.4	Silty clay, trace of sand, lt. br.			
12.4	15.2	Clay, tan, trace of sand			

7 CONTRACTOR'S OR LANDOWNER'S CERTIFICATION: This water well was (1) constructed, (2) reconstructed, or (3) plugged under my jurisdiction and was completed on (mo/day/year) 6/3/02 and this record is true to the best of my knowledge and belief. Kansas Water Well Contractor's Licence No. 531 This Water Well Record was completed on (mo/day/yr) 7/3/02 under the business name of Geotechnical Services, Inc by (signature) Alison M. Smith