


027148

1 LOCATION OF WATER WELL:	Fraction	Section Number	Township Number	Range Number
County: <u>McPherson</u>	<u>SW 1/4 NE 1/4 NW 1/4</u>	<u>29</u>	T <u>19</u> S	R <u>4</u> <u>EW</u>

Distance and direction from nearest town or city street address of well if located within city?  
0.5 mile W of Conway, N of Hwy 56

2 WATER WELL OWNER: Williams Midstream Natural Liquid Gas Inc.  
 RR#, St. Address, Box #: 1426 5th Ave. Board of Agriculture, Division of Water Resources  
 City, State, ZIP Code: McPherson KS 66460 Application Number:

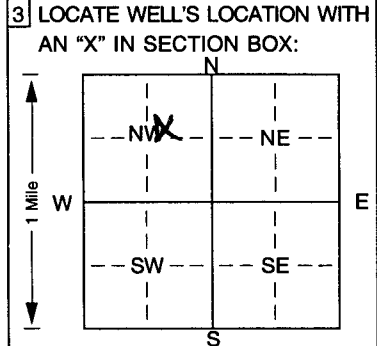

4 DEPTH OF COMPLETED WELL: 15 ft. ELEVATION:

Depth(s) Groundwater Encountered 1. . . . . ft. 2. . . . . ft. 3. . . . . ft.

WELL'S STATIC WATER LEVEL . . . . . ft. below land surface measured on mo/day/yr

Pump test data: Well water was . . . . . ft. after . . . . . hours pumping . . . . . gpm

Est. Yield . . . . . gpm: Well water was . . . . . ft. after . . . . . hours pumping . . . . . gpm

Bore Hole Diameter: 8.5 in. to 15 ft., and . . . . . in. to . . . . . ft.

WELL WATER TO BE USED AS: 5 Public water supply 8 Air conditioning 11 Injection well  
 1 Domestic 3 Feedlot 6 Oil field water supply 9 Dewatering 12 Other (Specify below)  
 2 Irrigation 4 Industrial 7 Domestic (lawn & garden) 10 Monitoring well TMW-7

Was a chemical/bacteriological sample submitted to Department? Yes. . . . . No. X; If yes, mo/day/yr sample was submitted  
 Water Well Disinfected? Yes . . . . . No X

5 TYPE OF BLANK CASING USED:

1 Steel	3 RMP (SR)	5 Wrought iron	8 Concrete tile	CASING JOINTS: Glued. . . . . Clamped. . . . .
<u>2 PVC</u>	4 ABS	6 Asbestos-Cement	9 Other (specify below)	Welded . . . . .
		7 Fiberglass		<u>Threaded</u> <u>Flush</u>

Blank casing diameter . . . . . 2 in. to 4.85 ft., Dia . . . . . in. to . . . . . ft., Dia . . . . . in. to . . . . . ft.

Casing height above land surface. . . . . 37.8 in., weight . . . . . 703 lbs./ft. Wall thickness or gauge No. Sch 40

TYPE OF SCREEN OR PERFORATION MATERIAL:

1 Steel	3 Stainless steel	5 Fiberglass	<u>7 PVC</u>	10 Asbestos-cement
2 Brass	4 Galvanized steel	6 Concrete tile	8 RMP (SR)	11 Other (specify) . . . . .
			9 ABS	12 None used (open hole)

SCREEN OR PERFORATION OPENINGS ARE:

1 Continuous slot	<u>3 Mill slot</u>	5 Gauzed wrapped	8 Saw cut	11 None (open hole)
2 Louvered shutter	4 Key punched	6 Wire wrapped	9 Drilled holes	
		7 Torch cut	10 Other (specify) . . . . .	ft.

SCREEN-PERFORATED INTERVALS: From . . . . . 4.85 ft. to . . . . . 14.85 ft., From . . . . . ft. to . . . . . ft.

GRAVEL PACK INTERVALS: From . . . . . 2.85 ft. to . . . . . 15 ft., From . . . . . ft. to . . . . . ft.

6 GROUT MATERIAL: 1 Neat cement 2 Cement grout 3 Bentonite 4 Other concrete

Grout Intervals: From . . . . . 0 ft. to . . . . . 0.85 ft., From . . . . . 0.85 ft. to . . . . . 2.85 ft., From . . . . . ft. to . . . . . ft.

What is the nearest source of possible contamination:

1 Septic tank	4 Lateral lines	7 Pit privy	10 Livestock pens	14 Abandoned water well
2 Sewer lines	5 Cess pool	8 Sewage lagoon	11 Fuel storage	15 Oil well/Gas well
3 Watertight sewer lines	6 Seepage pit	9 Feedyard	12 Fertilizer storage	16 Other (specify below)
			13 Insecticide storage	

Direction from well? . . . . . How many feet? . . . . .

FROM	TO	LITHOLOGIC LOG	FROM	TO	PLUGGING INTERVALS
0	5	Clay, some silt, reddish br.			
5	8.5	Clay, some silt, br.			
8.5	11	Clay & silt, br.			
11	15	Clay, some silt, br.			

7 CONTRACTOR'S OR LANDOWNER'S CERTIFICATION: This water well was (1) constructed, (2) reconstructed, or (3) plugged under my jurisdiction and was completed on (mo/day/year) . . . . . 6/24/02 . . . . . and this record is true to the best of my knowledge and belief. Kansas Water Well Contractor's Licence No. . . . . 531 . . . . . This Water Well Record was completed on (mo/day/yr) . . . . . 7/31/02 under the business name of Geotechnical Services, Inc. by (signature) William M. Fin