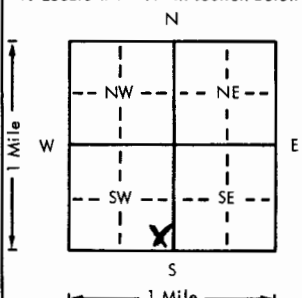


USE TYPEWRITER OR BALL
POINT PEN-PRESS FIRMLY,
PRINT CLEARLY.

WATER WELL RECORD
KSA 82a-1201-1215

Kansas Department of Health and
Environment-Division of Environment
(Water well Contractors)
Topeka, Kansas 66620

1. Location of well:		County <u>Mpherson</u>	Fraction <u>Sec 1/4 SE 1/4 SW 1/4</u>	Section number <u>1</u>	Township number <u>T 19 S</u>	Range number <u>R 4 E</u>
2. Distance and direction from nearest town or city: <u>3 N 2 1/2 W</u>		3. Owner of well: <u>Frank Hanson</u>				
Street address of well location if in city: <u>Mpherson</u>		R.R. or street: <u>RR 3</u>				
		City, state, zip code: <u>Mpherson Ks 67460</u>				
4. Locate with "X" in section below:		Sketch map:		6. Bore hole dia. <u>4</u> in. Completion date <u>11-7-77</u>		
				Well depth <u>130</u> ft.		
				7. Cable tool <input checked="" type="checkbox"/> Rotary <input type="checkbox"/> Driven <input type="checkbox"/> Dug <input type="checkbox"/> Hollow rod <input type="checkbox"/> Jetted <input type="checkbox"/> Bored <input type="checkbox"/> Reverse rotary		
5. Type and color of material				8. Use: <input type="checkbox"/> Domestic <input type="checkbox"/> Public supply <input type="checkbox"/> Industry <input type="checkbox"/> Irrigation <input type="checkbox"/> Air conditioning <input checked="" type="checkbox"/> Stock <input type="checkbox"/> Lawn <input type="checkbox"/> Oil field water <input type="checkbox"/> Other		
				9. Casing: Material <u>PVC</u> Height <u>Above</u> or below Threaded <input type="checkbox"/> Welded <input type="checkbox"/> Surface <u>10</u> in. RMP <input type="checkbox"/> PVC <input checked="" type="checkbox"/> Weight <u>80640</u> lbs./ft. Dia. <u>5</u> in. to <u>130</u> ft. depth Wall Thickness: inches or Dia. <u>5</u> in. to <u>130</u> ft. depth gage No. <u>258</u>		
				10. Screen: Manufacturer's name <u>ASTM</u> Type <u>PVC</u> Dia. <u>5</u> Slot/gauze <u>1/8</u> Length <u>10</u> Set between <u>120</u> ft. and <u>130</u> ft. ft. and <u>130</u> ft. Gravel pack? <input checked="" type="checkbox"/> Size range of material <u>1/4-3/8</u>		
				11. Static water level: <u>100</u> ft. below land surface Date <u>11-7-77</u> mo./day/yr.		
				12. Pumping level below land surfaces: ft. after <u> </u> hrs. pumping <u> </u> g.p.m. ft. after <u> </u> hrs. pumping <u> </u> g.p.m. Estimated maximum yield <u> </u> g.p.m.		
				13. Water sample submitted: <u> </u> mo./day/yr. Yes <input checked="" type="checkbox"/> No <input type="checkbox"/> Date <u> </u>		
				14. Well head completion: <input checked="" type="checkbox"/> Pitless adapter <u> </u> inches above grade		
				15. Well grouted? <input checked="" type="checkbox"/> With: <input type="checkbox"/> Neat cement <input type="checkbox"/> Bentonite <input checked="" type="checkbox"/> Concrete Depth: From <u>0</u> ft. to <u>10</u> ft.		
				16. Nearest source of possible contamination: <u>Cattle</u> ft. <u>60</u> Direction <u>W</u> Type <u>Barn</u> Well disinfected upon completion? <input checked="" type="checkbox"/> Yes <input type="checkbox"/> No		
				17. Pump: <input checked="" type="checkbox"/> Not installed Manufacturer's name <u> </u> Model number <u> </u> HP <u> </u> Volts <u> </u> Length of drop pipe <u> </u> ft. capacity <u> </u> g.p.m. Type: <input type="checkbox"/> Submersible <input type="checkbox"/> Turbine <input type="checkbox"/> Jet <input type="checkbox"/> Reciprocating <input type="checkbox"/> Centrifugal <input type="checkbox"/> Other		
				(Use a second sheet if needed)		
18. Elevation:		19. Remarks:		20. Water well contractor's certification: This well was drilled under my jurisdiction and this report is true to the best of my knowledge and belief. <u>Backhus Drgl. 180</u> Business name <u> </u> License No. <u> </u> Address <u> </u> Signed <u>Frank Backhus</u> Date <u>11-12-77</u> Authorized representative		
Topography: <input type="checkbox"/> Hill <input type="checkbox"/> Slope <input checked="" type="checkbox"/> Upland <input type="checkbox"/> Valley						

12 - 40 - 1 SE SE SW
T 19 S R 4 E