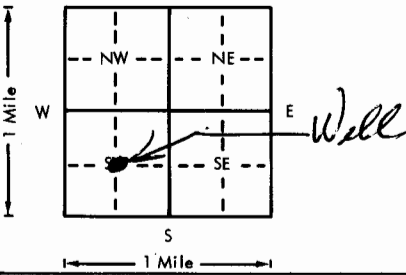


USE TYPEWRITER OR BALL  
POINT PEN-PRESS FIRMLY,  
PRINT CLEARLY.

WATER WELL RECORD  
KSA 82a-1201-1215

Kansas Department of Health and  
Environment-Division of Environment  
(Water well Contractors)  
Topeka, Kansas 66620

1. Location of well: County <u>McPherson</u> Fraction <u>Center of 1/4 1/4 SW 1/4</u> Section number <u>24</u> Township number <u>T 19 S R 4</u> Range number <u>NO</u>	
2. Distance and direction from nearest town or city: <u>3 miles West of McPherson, Kans</u>	
3. Owner of well: <u>PETE GOERING</u> R.R. or street: <u>735 E. Elizabeth ST.</u> City, state, zip code: <u>McPherson, Kans 67460</u>	
4. Locate with "X" in section below: Sketch map: 	
5. Type and color of material	
6. Bore hole dia. <u>30</u> in. Completion date <u>8-1-76</u> Well depth <u>215</u> ft.	
7. <input type="checkbox"/> Cable tool <input type="checkbox"/> Rotary <input type="checkbox"/> Driven <input type="checkbox"/> Dug <input type="checkbox"/> Hollow rod <input type="checkbox"/> Jetted <input type="checkbox"/> Bored <input checked="" type="checkbox"/> Reverse rotary	
8. Use: <input type="checkbox"/> Domestic <input type="checkbox"/> Public supply <input type="checkbox"/> Industry <input checked="" type="checkbox"/> Irrigation <input type="checkbox"/> Air conditioning <input type="checkbox"/> Stock <input type="checkbox"/> Lawn <input type="checkbox"/> Oil field water <input type="checkbox"/> Other	
9. Casing: Material <u>TRANSITE</u> Height: Above or below Threaded <input type="checkbox"/> Welded <input type="checkbox"/> Surface <u>12</u> in. RMP <input type="checkbox"/> PVC <input type="checkbox"/> Weight <input type="checkbox"/> lbs./ft. Dia. <u>16</u> in. to <u>215</u> ft. depth Wall Thickness: inches or Dia. <input type="checkbox"/> in. to <input type="checkbox"/> ft. depth gage No. <u>3/4</u>	
10. Screen: Manufacturer's name <u>AURORA TILE CO</u> Type <u>TRANSITE</u> Dia. <u>16" ID</u> Slot/gauze <u>1/8</u> Length <u>52</u> Set between <u>163</u> ft. and <u>215</u> ft. ft. and <input type="checkbox"/> ft. Gravel pack? <u>yes</u> Size range of material <u>1/4"</u>	
11. Static water level: <input type="checkbox"/> mo./day/yr. <u>84</u> ft. below land surface Date <u>8-10-76</u>	
12. Pumping level below land surfaces: <u>113</u> ft. after <u>6</u> hrs. pumping <u>800</u> g.p.m. <input type="checkbox"/> ft. after <input type="checkbox"/> hrs. pumping <input type="checkbox"/> g.p.m. Estimated maximum yield <u>1200</u> g.p.m.	
13. Water sample submitted: <input type="checkbox"/> mo./day/yr. Yes <input checked="" type="checkbox"/> No Date <input type="checkbox"/>	
14. Well head completion: <input type="checkbox"/> Pitless adapter <u>12</u> inches above grade	
15. Well grouted? <u>yes Puddled clay</u> With: <input type="checkbox"/> Neat cement <input type="checkbox"/> Bentonite <input type="checkbox"/> Concrete Depth: From <u>0</u> ft. to <u>10</u> ft.	
16. Nearest source of possible contamination: ft. <u>1300</u> Direction <u>E</u> Type <u>Well</u> Well disinfected upon completion? <input type="checkbox"/> Yes <input checked="" type="checkbox"/> No	
17. Pump: <input type="checkbox"/> Not installed Manufacturer's name <u>Western Electric</u> Model number <u>8m</u> HP <input type="checkbox"/> Volts <input type="checkbox"/> Length of drop pipe <u>150</u> ft. capacity <input type="checkbox"/> g.p.m. Type: <input type="checkbox"/> Submersible <input checked="" type="checkbox"/> Turbine <input type="checkbox"/> Jet <input type="checkbox"/> Reciprocating <input type="checkbox"/> Centrifugal <input type="checkbox"/> Other	
18. Elevation: <u>1500</u> Topography: <input type="checkbox"/> Hill <input type="checkbox"/> Slope <input checked="" type="checkbox"/> Upland <input type="checkbox"/> Valley	
19. Remarks:	
20. Water well contractor's certification: This well was drilled under my jurisdiction and this report is true to the best of my knowledge and belief. <u>Peterson Irrigation Inc</u> <u>138A</u> Business name License No. Address <u>Box 150 Levenshoy, KS</u> Signed <u>Wallace Peterson</u> Date <u>1-5-76</u> Authorized representative	