WATER WELL RECORD Form WWC-5 KSA 82a-1212

1 LOCATION OF WATER WELL: County: McPherson | Fraction: SE ¼ SE ¼ SE ¼ | Section Number: 24 | Township Number: T 19 S | Range Number: R 4 E/W

Distance and direction from nearest town or city? 1 mi. W. OF McPHERSON KS. | Street address of well if located within city?

2 WATER WELL OWNER: Johnnie Dossett
RR#, St. Address, Box # : RR2
City, State, ZIP Code : McPherson, Ks. 67460
Board of Agriculture, Division of Water Resources Application Number:

3 DEPTH OF COMPLETED WELL 205 ft. Bore Hole Diameter 8 in. to 205 ft., and in. to ft.

Well Water to be used as: (1) Domestic 2 Irrigation 3 Feedlot 4 Industrial 5 Public water supply 6 Oil field water supply 7 Lawn and garden only 8 Air conditioning 9 Dewatering 10 Observation well 11 Injection well 12 Other (Specify below)

Well's static water level 100 ft. below land surface measured on 2 month 12 day 81 year

Pump Test Data: Well water was 116 ft. after 1½ hours pumping 10 gpm
Est. Yield 30-50 gpm: Well water was ft. after hours pumping gpm

4 TYPE OF BLANK CASING USED: (2) PVC 1 Steel 3 RMP (SR) 4 ABS 5 Wrought iron 6 Asbestos-Cement 7 Fiberglass 8 Concrete tile 9 Other (specify below)
Casing Joints: Glued X Clamped Welded Threaded

Blank casing dia 4 in. to 185 ft., Dia in. to ft., Dia in. to ft.
Casing height above land surface 12 in., weight 1.55 lbs./ft. Wall thickness or gauge No .173

TYPE OF SCREEN OR PERFORATION MATERIAL: (7) PVC 1 Steel 2 Brass 3 Stainless steel 4 Galvanized steel 5 Fiberglass 6 Concrete tile 8 RMP (SR) 9 ABS 10 Asbestos-cement 11 Other (specify) 12 None used (open hole)

Screen or Perforation Openings Are: (3) Mill slot 1 Continuous slot 2 Louvered shutter 4 Key punched 5 Gauzed wrapped 6 Wire wrapped 7 Torch cut 8 Saw cut 9 Drilled holes 10 Other (specify) 11 None (open hole)

Screen-Perforation Dia 4 in. to 205 ft., Dia in. to ft., Dia in to ft.
Screen-Perforated Intervals: From 185 ft. to 205 ft., From ft. to ft.
From ft. to ft., From ft. to ft.
Gravel Pack Intervals: From 205 ft. to 21 ft., From ft. to ft.
From ft. to ft., From ft. to ft.

5 GROUT MATERIAL: (1) Neat cement 2 Cement grout 3 Bentonite 4 Other
Grouted Intervals: From 21 ft. to 5 ft., From ft. to ft., From ft. to ft.

What is the nearest source of possible contamination: 1 Septic tank 2 Sewer lines (3) Lateral lines 4 Cess pool 5 Seepage pit 6 Pit privy 7 Sewage lagoon 8 Feed yard 9 Livestock pens 10 Fuel storage 11 Fertilizer storage 12 Insecticide storage 13 Watertight sewer lines 14 Abandoned water well 15 Oil well/Gas well 16 Other (specify below)

Direction from well West How many feet 150 ? Water Well Disinfected? Yes X No
Was a chemical/bacteriological sample submitted to Department? Yes No X : If yes, date sample was submitted month day year: Pump Installed? Yes No X
If Yes: Pump Manufacturer's name Model No. HP Volts
Depth of Pump Intake ft. Pumps Capacity rated at gal./min.
Type of pump: 1 Submersible 2 Turbine 3 Jet 4 Centrifugal 5 Reciprocating 6 Other

6 CONTRACTOR'S OR LANDOWNER'S CERTIFICATION: This water well was (1) constructed (2) reconstructed, or (3) plugged under my jurisdiction and was completed on 2 month 12 day 81 year and this record is true to the best of my knowledge and belief. Kansas Water Well Contractor's License No. 138
This Water Well Record was completed on 3 month 6 day 81 year under the business name of PETERSON IRRIGATION INC. by (signature) Mike Peterson

7 LOCATE WELL'S LOCATION WITH AN "X" IN SECTION BOX:

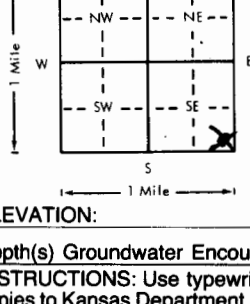

ELEVATION:

FROM	TO	LITHOLOGIC LOG	FROM	TO	LITHOLOGIC LOG
0	3	Top soil	193	199	Linestone-hard
3	8	Clay - Grey	199	202	Clay - grey
8	21	Clay - Brown	202	205	Sand - coarse
21	61	Clay - Pink - Sandy			
61	70	Sand - Dry			
70	72	Clay - Pink			
72	93	Sand - Dry			
93	110	Clay - Bluff			
110	122	Sand - Med. - water			
122	135	Clay - buff			
135	193	Sand - Med			

Depth(s) Groundwater Encountered 1. 110 ft. 2. ft. 3. ft. 4. ft. (Use a second sheet if needed)

INSTRUCTIONS: Use typewriter or ball point pen, *please press firmly* and *PRINT* clearly. Please fill in blanks, underline or circle the correct answers. Send top three copies to Kansas Department of Health and Environment, Division of Environment, Water Well Contractors, Topeka, KS 66620. Send one to WATER WELL OWNER and retain one for your records.

OFFICE USE ONLY T 19 R 4 E/W SEC 24 SE ¼ SE ¼ SE ¼