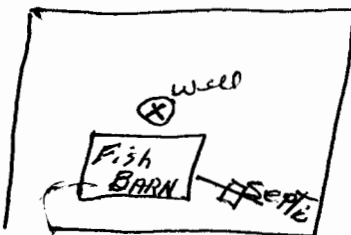


USE TYPEWRITER OR BALL
POINT PEN-PRESS FIRMLY,
PRINT CLEARLY.

WATER WELL RECORD
KSA 82a-1201-1215

19 4 W 22 S W 1/4 NE
T R EW sec 1/4 1/4 1/4 No.

Kansas State Dept. Of Health
(Water Well Contractors)
Forbes-Bldg. 740
Topeka, Kansas 66620

1 Location of well:	County <u>McPherson</u>	Township name <u>Jackson</u>	Fraction <u>SW 1/4</u>	Section number <u>27</u>	Town number <u>T195</u>	Range number <u>4W</u>	
Distance and direction from nearest town or city: <u>1 3/4 Mile East Conway Kansas.</u>				3 Owner of well: <u>Glenn Culver</u> Address: <u>720 W KANSAS</u>	
Street address of well location if in city:				67460	
Locate with "X" in section below: N W E S 1 Mile		Sketch map: 		4 Well depth: <u>135</u> ft. Date of completion <u>9-26-75</u> Well diameter <u>8"</u> in.	
<table border="1"><tr><th>2</th><th>Type and color of material</th><th>From</th><th>To</th></tr><tr><td><u>Dark top soil</u></td><td><u>0</u></td><td><u>6</u></td></tr><tr><td><u>Gray clay</u></td><td><u>6</u></td><td><u>14</u></td></tr><tr><td><u>Buff clay</u></td><td><u>14</u></td><td><u>21</u></td></tr><tr><td><u>Brown clay (lost circulation)</u></td><td><u>21</u></td><td><u>30</u></td></tr><tr><td><u>Buff yellow clay</u></td><td><u>30</u></td><td><u>55</u></td></tr><tr><td><u>Very fine dry sands</u></td><td><u>55</u></td><td><u>60</u></td></tr><tr><td><u>Med sands (Iron oxide) dry</u></td><td><u>60</u></td><td><u>80</u></td></tr><tr><td><u>Very fine sands</u></td><td><u>80</u></td><td><u>85</u></td></tr><tr><td><u>Med Equi sands</u></td><td><u>85</u></td><td><u>96</u></td></tr><tr><td><u>Blue clay</u></td><td><u>96</u></td><td><u>102</u></td></tr><tr><td><u>Med Equi sands</u></td><td><u>102</u></td><td><u>130</u></td></tr><tr><td><u>Blue shale</u></td><td><u>130</u></td><td><u>135</u></td></tr><u>85</u>	<u>Med Equi sands</u>	<u>85</u>	<u>96</u>	<u>Blue clay</u>	<u>96</u>	<u>102</u>	<u>Med Equi sands</u>	<u>102</u>	<u>130</u>	<u>Blue shale</u>	<u>130</u>	<u>135</u>	5 <input type="checkbox"/> Cable tool <input checked="" type="checkbox"/> Rotary <input type="checkbox"/> Driven <input type="checkbox"/> Dug <input type="checkbox"/> Hollow rod <input type="checkbox"/> Jetted <input type="checkbox"/> Bored <input type="checkbox"/> Reverse rotary		
				6 Use: <input checked="" type="checkbox"/> Domestic <input type="checkbox"/> Public supply <input checked="" type="checkbox"/> Industry <input type="checkbox"/> Irrigation <input type="checkbox"/> Air conditioning <input checked="" type="checkbox"/> Commercial <input type="checkbox"/> Test well <input type="checkbox"/> <u>Fish Farm</u>	
				7 Casing: Material <u>PVC</u> Height: <u>above</u> below Threaded <input type="checkbox"/> Welded <input checked="" type="checkbox"/> Surface <u>12"</u> in. Diam. _____ Weight _____ lbs./ft. _____ <u>5"</u> in. to <u>136</u> ft. depth Drive shoe? <input type="checkbox"/> Yes <input checked="" type="checkbox"/> No _____ in. to _____ ft. depth	
				8 Screen: Manufacturer <u>Cortian Steel</u> Type <u>PVC</u> Dia. <u>5"</u> Slot/gauze <u>1/32</u> Length <u>20 ft</u> Set between <u>145</u> ft. and <u>135</u> ft. Fittings: <u>Y8 - Y4"</u> Gravel pack <input checked="" type="checkbox"/> Yes <input type="checkbox"/> No Size range of material _____	
				9 Static water level: <u>80</u> ft. below land surface Date <u>9-26-75</u>	
				10 Pumping level below land surfaces: <u>85</u> ft. after <u>2</u> hrs. pumping <u>15</u> g.p.m. _____ ft. after _____ hrs. pumping _____ g.p.m. Estimated maximum yield <u>100</u> g.p.m.	
				11 Water sample submitted: <input type="checkbox"/> Yes <input checked="" type="checkbox"/> No Date _____	
				12 Well head completion: <input checked="" type="checkbox"/> Pitless adapter <input type="checkbox"/> Inches above grade	
				13 Well grouted? <input checked="" type="checkbox"/> Yes <input type="checkbox"/> No <input checked="" type="checkbox"/> Neat cement <input type="checkbox"/> Bentonite <input type="checkbox"/> _____ Depth: From <u>5</u> ft. to <u>15</u> ft.	
				14 Nearest source of possible contamination: ft. <u>100</u> Direction <u>S.E.</u> Type <u>Septic</u> Well disinfected upon completion? <input checked="" type="checkbox"/> Yes <input type="checkbox"/> No	
				15 Pump: <input checked="" type="checkbox"/> Not installed Manufacturer's name _____ Model number _____ HP _____ Volts _____ Length of drop pipe _____ ft. capacity _____ g.m.p. Type: <input checked="" type="checkbox"/> Submersible <input type="checkbox"/> Turbine <input type="checkbox"/> Jet <input type="checkbox"/> Reciprocating <input type="checkbox"/> Centrifugal <input type="checkbox"/> Other	
16 Remarks: elevation Topography: <input type="checkbox"/> Hill <input type="checkbox"/> Slope <input checked="" type="checkbox"/> Upland <input type="checkbox"/> Valley				17 Water well contractor's certification: This well was drilled under my jurisdiction and this report is true to the best of my knowledge and belief. <u>Peterson Bros Inc</u> 138 Business name License No. Address <u>Box 150 Lindenberg Mo</u> Signed <u>Wally Peterson</u> Date <u>9-27-75</u> Authorized representative	