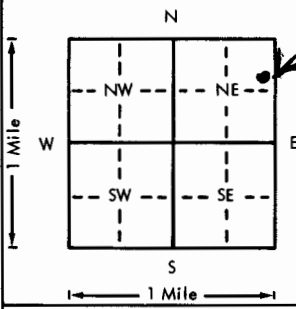


USE TYPEWRITER OR BALL
POINT PEN-PRESS FIRMLY,
PRINT CLEARLY.

WATER WELL RECORD
KSA 82a-1201-1215

Kansas Department of Health and
Environment-Division of Environment
(Water well Contractors)
Topeka, Kansas 66620

1. Location of well: County <u>McPHERSON</u>		Fraction <u>1/4 NE 1/4 NE 1/4</u>	Section number <u>28</u>	Township number <u>T 19 S R 4 E</u>	Range number <u>4</u>
2. Distance and direction from nearest town or city: <u>1 1/2 miles East of Conway, Kansas</u>			3. Owner of well: <u>MIDWEST STORAGE</u> R.R. or street: <u>CONWAY, KANSAS</u> City, state, zip code:		
4. Locate with "X" in section below: 			Sketch map: <u>WELL #3</u> <u>WATER SUPPLY.</u> <u>WELL FOR MIDWEST</u> <u>STORAGE. CONWAY, KANSAS</u>		
5. Type and color of material			From	To	6. Bore hole dia. <u>3 1/2</u> in. Completion date <u>11-18-76</u> Well depth <u>132</u> ft. <u>76</u>
					7. <input type="checkbox"/> Cable tool <input type="checkbox"/> Rotary <input type="checkbox"/> Driven <input type="checkbox"/> Dug <input type="checkbox"/> Hollow rod <input type="checkbox"/> Jetted <input type="checkbox"/> Bored <input checked="" type="checkbox"/> Reverse rotary
					8. Use: <input type="checkbox"/> Domestic <input type="checkbox"/> Public supply <input checked="" type="checkbox"/> Industry <input type="checkbox"/> Irrigation <input type="checkbox"/> Air conditioning <input type="checkbox"/> Stock <input type="checkbox"/> Lawn <input type="checkbox"/> Oil field water <input type="checkbox"/> Other
					9. Casing: Material <u>PVC</u> Height: Above or below Threaded <input type="checkbox"/> Welded <input type="checkbox"/> Surface <u>24</u> in. RMP <input type="checkbox"/> PVC <input checked="" type="checkbox"/> Weight <u>20</u> lbs./ft. Dia. <u>1 1/2</u> in. to <u>132</u> ft. depth Wall Thickness: inches or Dia. <u>1 1/2</u> in. to <u>132</u> ft. depth gauge No. <u>42</u>
					10. Screen: Manufacturer's name <u>JET STREAM</u> Type <u>P.I.C.</u> Dia. <u>1 1/2</u> in. Slot/gauze <u>18</u> Length <u>40 ft</u> Set between <u>92</u> ft. and <u>132</u> ft. ft. and <u>132</u> ft. Gravel pack? <u>yes</u> Size range of material <u>1/4"</u>
					11. Static water level: <u>72</u> ft. below land surface Date <u>11-18-76</u> mo./day/yr.
					12. Pumping level below land surfaces: <u>72</u> ft. after <u>0</u> hrs. pumping <u>0</u> g.p.m. <u>72</u> ft. after <u>0</u> hrs. pumping <u>0</u> g.p.m. Estimated maximum yield <u>1000</u> g.p.m.
					13. Water sample submitted: <u>0</u> mo./day/yr. Yes <input checked="" type="checkbox"/> No <input type="checkbox"/> Date <u>11-18-76</u>
					14. Well head completion: <input type="checkbox"/> Pitless adapter <u>24</u> inches above grade
					15. Well grouted? <u>yes</u> - <u>Puddled</u> With: <u>Neat cement</u> <u>Bentonite</u> <u>Concrete</u> Depth: From <u>0</u> ft. to <u>15</u> ft.
					16. Nearest source of possible contamination: ft. <u>400</u> Direction <u>West</u> Type <u>Salt Pit</u> Well disinfected upon completion? <u>Yes</u> <input checked="" type="checkbox"/> No <input type="checkbox"/>
					17. Pump: <input checked="" type="checkbox"/> Not installed Manufacturer's name <u>Jet Stream</u> Model number <u>138A</u> HP <u>1/2</u> Volts <u>115</u> Length of drop pipe <u>132</u> ft. capacity <u>1000</u> g.p.m. Type: <input type="checkbox"/> Submersible <input type="checkbox"/> Turbine <input type="checkbox"/> Jet <input type="checkbox"/> Reciprocating <input type="checkbox"/> Centrifugal <input type="checkbox"/> Other
18. Elevation:			19. Remarks: <u>Cased 132 ft.</u> <u>at 2600 psi ft</u>		
Topography: <input type="checkbox"/> Hill <input type="checkbox"/> Slope <input checked="" type="checkbox"/> Upland <input type="checkbox"/> Valley			20. Water well contractor's certification: This well was drilled under my jurisdiction and this report is true to the best of my knowledge and belief. <u>McPHERSON, Inc.</u> <u>138A</u> Business name License No. Address <u>Box 150 Linwood, KS</u> Signed <u>William R. Peterson</u> Date <u>11-18-76</u> Authorized representative		