


1 LOCATION OF WATER WELL: County: McPherson	Fraction SW 1/4 SE 1/4 SW 1/4	Section Number 28	Township Number T 19 S	Range Number R 4 <del>W</del>
--	----------------------------------	----------------------	---------------------------	----------------------------------

Distance and direction from nearest town or city street address of well if located within city?  
 Approximately 3/4 mile east of Conway

2 WATER WELL OWNER: Koch Underground Storage  
 RR#, St. Address, Box #: Route 2 - Box 181  
 City, State, ZIP Code: McPherson, KS 67460  
 Board of Agriculture, Division of Water Resources  
 Application Number:

3 LOCATE WELL'S LOCATION WITH AN "X" IN SECTION BOX: 4 DEPTH OF COMPLETED WELL: 57 ft. ELEVATION: unknown

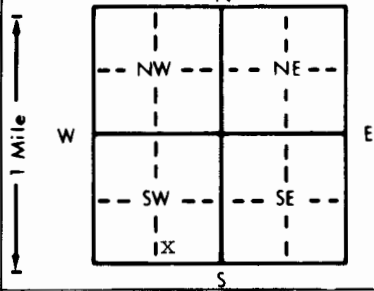

Depth(s) Groundwater Encountered 1. ft. 2. ft. 3. ft.  
 WELL'S STATIC WATER LEVEL 23 ft. below land surface measured on mo/day/yr 4-14-93  
 Pump test data: Well water was Not ch'd. ft. after hours pumping gpm  
 Est. Yield unknown gpm: Well water was ft. after hours pumping gpm  
 Bore Hole Diameter 1.1 in. to 55 ft., and in. to ft.  
 WELL WATER TO BE USED AS:  
 5 Public water supply 8 Air conditioning 11 Injection well  
 1 Domestic 3 Feedlot 6 Oil field water supply 9 Dewatering 12 Other (Specify below)  
 2 Irrigation 4 Industrial 7 Lawn and garden only 10 ~~Monitoring well~~ Remedial Well  
 Was a chemical/bacteriological sample submitted to Department? Yes No X; If yes, mo/day/yr sample was submitted  
 Water Well Disinfected? Yes No X

5 TYPE OF BLANK CASING USED:  
 1 Steel 3 RMP (SR) 5 Wrought iron 8 Concrete tile CASING JOINTS: Glued X Clamped  
 2 PVC 4 ABS 6 Asbestos-Cement 9 Other (specify below) Welded  
 7 Fiberglass Threaded

Blank casing diameter 5 in. to 20 ft., Dia. in. to ft., Dia. in. to ft.  
 Casing height above land surface 24 in., weight 2.87 lbs./ft. Wall thickness or gauge No. 265

TYPE OF SCREEN OR PERFORATION MATERIAL:  
 1 Steel 3 Stainless steel 5 Fiberglass 7 PVC 10 Asbestos-cement  
 2 Brass 4 Galvanized steel 6 Concrete tile 8 RMP (SR) 11 Other (specify)  
 9 ABS 12 None used (open hole)

SCREEN OR PERFORATION OPENINGS ARE:  
 1 Continuous slot 3 Mill slot 5 Gauzed wrapped 8 Saw cut 11 None (open hole)  
 2 Louvered shutter 4 Key punched 6 Wire wrapped 9 Drilled holes  
 7 Torch cut 10 Other (specify)

SCREEN-PERFORATED INTERVALS: From 20 ft. to 55 ft., From ft. to ft.  
 GRAVEL PACK INTERVALS: From 18 ft. to 55 ft., From ft. to ft.

6 GROUT MATERIAL: 1 Neat cement 2 Cement grout 3 Bentonite 4 Other Bentonite Holeplug  
 Grout Intervals: From 0 ft. to 18 ft., From ft. to ft., From ft. to ft.

What is the nearest source of possible contamination:  
 1 Septic tank 4 Lateral lines 7 Pit privy 10 Livestock pens 14 Abandoned water well  
 2 Sewer lines 5 Cess pool 8 Sewage lagoon 11 Fuel storage 15 Oil well/Gas well  
 3 Watertight sewer lines 6 Seepage pit 9 Feedyard 12 Fertilizer storage 16 Other (specify below)  
 13 Insecticide storage Brine Pit  
 Direction from well? east How many feet? 22'

FROM	TO	LITHOLOGIC LOG	FROM	TO	PLUGGING INTERVALS
0	3	Topsoil, clay, black			
3	17	Clay, brown			
17	20	Clay, reddish, soft			
20	25	Sand, fine, very fine			
25	32	Shale, soft, red, green			
32	36	Shale, red			
36	40	Shale, green			
40	44	Shale, red			
44	51	Shale, red, green			
51	55	Shale, red, hard			

7 CONTRACTOR'S OR LANDOWNER'S CERTIFICATION: This water well was (1) constructed, (2) reconstructed, or (3) plugged under my jurisdiction and was completed on (mo/day/year) 4-14-93 and this record is true to the best of my knowledge and belief. Kansas Water Well Contractor's License No. 185 This Water Well Record was completed on (mo/day/yr) 4-23-93 under the business name of Clarke Well & Equipment, Inc. by (signature)