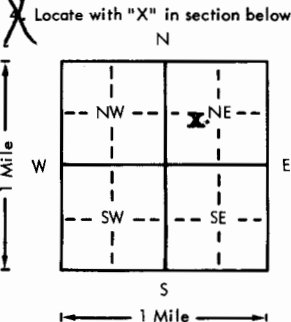
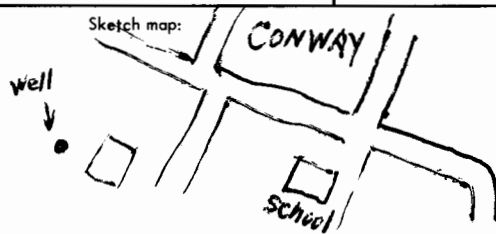


USE TYPEWRITER OR BALL POINT PEN-PRESS FIRMLY, PRINT CLEARLY.

WATER WELL RECORD  
KSA 82a-1201-1215

Kansas Department of Health and Environment-Division of Environment  
(Water well Contractors)  
Topeka, Kansas 66620

1. Location of well:		County <b>McPherson</b>	Fraction <b>NE 1/4 SW 1/4 NE 1/4</b>	Section number <b>29-</b>	Township number <b>T 19</b>	Range number <b>S R 4 W</b>	E/W <b>E/W</b>
2. Distance and direction from nearest town or city: Street address of well location if in city:			3. Owner of well: R.R. or street: City, state, zip code:				
<b>South part of Conway</b>			<b>Fayne Beattie</b> <b>Box 2</b> <b>Conway, Kansas 67434</b>				
4. Locate with "X" in section below: 		Sketch map: 			6. Bore hole dia. <u>9</u> in. Completion date <u>5-10</u> Well depth <u>82</u> ft.		
5. Type and color of material		From	To	7. <input checked="" type="checkbox"/> Cable tool <input type="checkbox"/> Rotary <input type="checkbox"/> Driven <input type="checkbox"/> Dug <input type="checkbox"/> Hollow rod <input type="checkbox"/> Jetted <input type="checkbox"/> Bored <input type="checkbox"/> Reverse rotary			
Loam		0	4	8. Use: <input checked="" type="checkbox"/> Domestic <input type="checkbox"/> Public supply <input type="checkbox"/> Industry <input type="checkbox"/> Irrigation <input type="checkbox"/> Air conditioning <input type="checkbox"/> Stock <input type="checkbox"/> Lawn <input type="checkbox"/> Oil field water <input type="checkbox"/> Other			
Clay		4	20	9. Casing: Material <u>PVC</u> Height: Above or below Threaded <input type="checkbox"/> Welded <input type="checkbox"/> Surface <u>24</u> in. RMP <input type="checkbox"/> PVC <input type="checkbox"/> Weight <input type="checkbox"/> lbs./ft. Dia. <u>6</u> in. to <u>82</u> ft. depth Wall Thickness: inches or Dia. <input type="checkbox"/> in. to <input type="checkbox"/> ft. depth gage No. <u>1</u>			
Shale Red		20	82	10. Screen: Manufacturer's name _____ Type <u>PVC</u> Dia. <u>6</u> " Slot/gauze <u>1/8</u> Length <u>27</u> Set between <u>55</u> ft. and <u>82</u> perforation _____ ft. and _____ ft. Gravel pack? <input checked="" type="checkbox"/> Size range of material <u>1/2 to 1</u>			
Water vein at		64 ft.		11. Static water level: <u>38</u> ft. below land surface Date <u>5-10-78</u> mo./day/yr.			
Water vein at		75 ft.		12. Pumping level below land surfaces: <u>64</u> ft. after <u>1</u> hrs. pumping <u>15</u> g.p.m. _____ ft. after _____ hrs. pumping _____ g.p.m. Estimated maximum yield <u>15</u> g.p.m.			
				13. Water sample submitted: _____ mo./day/yr. Yes <input type="checkbox"/> No <input checked="" type="checkbox"/> Date _____			
				14. Well head completion: <input checked="" type="checkbox"/> Pitless adapter <u>21</u> inches above grade			
				15. Well grouted? <u>yes</u> With: <input checked="" type="checkbox"/> Negt cement <input type="checkbox"/> Bentonite <input type="checkbox"/> Concrete Depth: From <u>5</u> ft. to <u>15</u> ft. <u>47</u> to <u>54</u>			
				16. Nearest source of possible contamination: ft. _____ Direction _____ Type _____ Well disinfected upon completion? <input checked="" type="checkbox"/> Yes <input type="checkbox"/> No			
				17. Pump: _____ Not installed Manufacturer's name <u>Flint &amp; Walling</u> Model number <u>7BA12</u> HP <u>3/4</u> Volts <u>230</u> Length of drop pipe <u>70</u> ft. capacity <u>10</u> g.p.m. Type: <input checked="" type="checkbox"/> Submersible <input type="checkbox"/> Turbine <input type="checkbox"/> Jet <input type="checkbox"/> Reciprocating <input type="checkbox"/> Centrifugal <input type="checkbox"/> Other			
				(Use a second sheet if needed)			
18. Elevation: <b>1530 ft.</b>		19. Remarks:		20. Water well contractor's certification: This well was drilled under my jurisdiction and this report is true to the best of my knowledge and belief. <b>Beattie Water Well Service</b> Business name _____ License No. <u>254</u> Address <u>Conway, Kansas</u> Signed <u>Fayne Beattie</u> Date <u>5-2-78</u> Authorized representative			
Topography: <input type="checkbox"/> Hill <input type="checkbox"/> Slope <input checked="" type="checkbox"/> Upland <input type="checkbox"/> Valley							

19 4 W E 29 NE SW NE  
 T R Sec 1/4 1/4 1/4 1/4