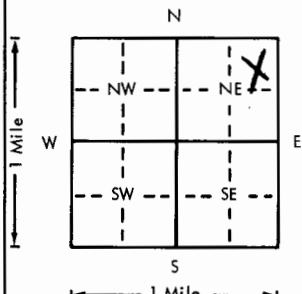


USE TYPEWRITER OR BALL  
POINT PEN-PRESS FIRMLY,  
PRINT CLEARLY.

WATER WELL RECORD  
KSA 82a-1201-1215

Kansas Department of Health and  
Environment-Division of Environment  
(Water well Contractors)  
Topeka, Kansas 66620

|   |  |                                |  |  |                                |                                 |
|---|--|--------------------------------|--|--|--------------------------------|---------------------------------|
| 1. Location of well:  |  | County<br><u>McPherson</u>     | Fraction<br><u>C 1/4 NE 1/4 NE 1/4</u> | Section number<br><u>29</u>  | Township number<br><u>T 19</u> | Range number<br><u>S R 4 NW</u> |
| 2. Distance and direction from nearest town or city:<br><u>1/2 W of Conway Ks.</u><br>Street address of well location if in city: |  |                                |  | 3. Owner of well: <u>N.C.R.A.</u><br>R.R. or street: <u>Box 908</u><br>City, state, zip code: <u>Conway, Ks.</u> <u>McPherson, Ks.</u>   |                                |                                 |
| 4. Locate with "X" in section below:  |  | Sketch map:                    |  | 6. Bore hole dia. <u>9 7/8</u> . Completion date <u>12-17-76</u><br>Well depth <u>138</u> ft.  |                                |                                 |
|   |  |                                |  | 7. <u>  </u> Cable tool <u>  </u> Rotary <u>  </u> Driven <u>  </u> Dug<br><u>  </u> Hollow rod <u>  </u> Jetted <u>  </u> Bored <u>  </u> Reverse rotary  |                                |                                 |
| 5. Type and color of material   |  | From                           | To                                     | 8. Use: <u>  </u> Domestic <u>  </u> Public supply <u>  </u> Industry<br><u>  </u> Irrigation <u>  </u> Air conditioning <u>  </u> Stock<br><u>  </u> Lawn <u>  </u> Oil field water <u>x</u> Other observation  |                                |                                 |
| Top Soil  |  | 0                              | 3                                      | 9. Casing: Material <u>PVC</u> Height: Above or below<br>Threaded <u>  </u> Welded <u>X</u> Surface <u>24</u> in.<br>RMP <u>  </u> PVC <u>  </u> Weight <u>160</u> lbs./ft. <u>220</u><br>Dia. <u>4 1/2</u> in. to <u>140</u> ft. depth Wall Thickness: inches or<br>Dia. <u>  </u> in. to <u>  </u> ft. depth gage No. <u>1-1-34</u> <u>sche 40</u>               |                                |                                 |
| Hard Brown Clay   |  | 3                              | 14                                     | 10. Screen: Manufacturer's name <u>R/B</u><br>Type <u>pvc</u> Dia. <u>4 1/2</u><br>Slot/gauge <u>1/16</u> Length <u>5</u><br>Set between <u>135</u> ft. and <u>140</u> ft.<br><u>  </u> ft. and <u>  </u> ft. <u>3/8</u><br>Gravel pack? <u>X</u> Size range of material <u>2</u> to <u>3/4</u>  |                                |                                 |
| Soft Clay   |  | 14                             | 22                                     | 11. Static water level:<br><u>49 1/2</u> ft. below land surface Date <u>12-17-76</u> <u>mo./day/yr.</u>  |                                |                                 |
| Red Bed   |  | 22                             | 27                                     | 12. Pumping level below land surfaces:<br><u>90</u> ft. after <u>1</u> hrs. pumping <u>10</u> g.p.m.<br><u>  </u> ft. after <u>  </u> hrs. pumping <u>  </u> g.p.m.<br>Estimated maximum yield <u>20</u> g.p.m.  |                                |                                 |
| Red Green Shale   |  | 27                             | 60                                     | 13. Water sample submitted: <u>  </u> mo./day/yr.<br><u>X</u> Yes <u>  </u> No Date <u>12-17-76</u>  |                                |                                 |
| Soft Red Green Shale  |  | 60                             | 64                                     | 14. Well head completion:<br><u>  </u> Pitless adapter <u>24</u> Inches above grade  |                                |                                 |
| Soft Red Green Shale  |  | 64                             | 76                                     | 15. Well grouted? <u>  </u><br>With: <u>  </u> Neat cement <u>  </u> Bentonite <u>X</u> Concrete<br>Depth: From <u>0</u> ft. to <u>10</u> ft.  |                                |                                 |
| Red Bed   |  | 76                             | 102                                    | 16. Nearest source of possible contamination:<br>ft. <u>40</u> Direction <u>North</u> Type <u>gas well</u><br>Well disinfected upon completion? <u>X</u> Yes <u>  </u> No  |                                |                                 |
| Red Green Shale   |  | 102                            | 120                                    | 17. Pump: <u>X</u> Not installed<br>Manufacturer's name <u>  </u><br>Model number <u>  </u> HP <u>  </u> Volts <u>  </u><br>Length of drop pipe <u>  </u> ft. capacity <u>  </u> g.p.m.<br>Type:<br><u>  </u> Submersible <u>  </u> Turbine<br><u>  </u> Jet <u>  </u> Reciprocating<br><u>  </u> Centrifugal <u>  </u> Other                                      |                                |                                 |
| Soft Red Bed  |  | 120                            | 138                                    | 20. Water well contractor's certification:<br>This well was drilled under my jurisdiction and this report<br>is true to the best of my knowledge and belief.<br><u>Rosencrantz-Bemis</u> <u>134</u><br>Business name <u>Great Bend, Ks.</u> License No. <u>  </u><br>Address <u>  </u><br>Signed <u>India Dorkson</u> Date <u>1/1</u><br>Authorized representative |                                |                                 |
| 18. Elevation:  |  | 19. Remarks:                   |  |  |                                |                                 |
| Topography:<br><u>  </u> Hill<br><u>X</u> Slope<br><u>  </u> Upland<br><u>  </u> Valley   |  | (Use a second sheet if needed) |  |  |                                |                                 |