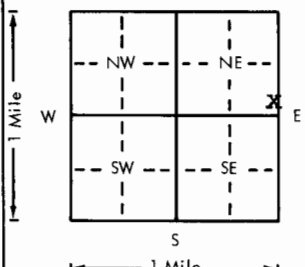


USE TYPEWRITER OR BALL
POINT PEN-PRESS FIRMLY,
PRINT CLEARLY.

WATER WELL RECORD
KSA 82a-1201-1215

Kansas Department of Health and
Environment-Division of Environment
(Water well Contractors)
Topeka, Kansas 66620

1. Location of well:		County McPherson	Fraction se 1/4 se 1/4 ne 1/4	Section number 34	Township number T 19 S	Range number R 4 E/W
2. Distance and direction from nearest town or city: 3-E 1-1/2-S west side rd. from Conway, Ks. Street address of well location if in city:			3. Owner of well: Home Petroleum R.R. or street: Box 181 City, state, zip code: McPherson, Kansas 67460			
4. Locate with "X" in section below: N  W E S 1 Mile			Sketch map: 6. Bore hole dia. 29 in. Completion date _____ Well depth 124 ft. 9-21-77			
5. Type and color of material			From	To	7. Cable tool <input checked="" type="checkbox"/> Rotary _____ Driven _____ Dug _____ Hollow rod _____ Jetted _____ Bored _____ Reverse rotary _____	
top soil			0	4	8. Use: _____ Domestic _____ Public supply _____ Industry _____ <input checked="" type="checkbox"/> Irrigation _____ Air conditioning _____ Stock _____ Lawn _____ Oil field water _____ Other _____	
clay			4	54	9. Casing: Material steel Height: Above or below _____ Threaded _____ Welded _____ Surface 18 in. RMP _____ PVC _____ Weight _____ lbs./ft. Dia. 16 in. to 124 ft. depth Wall Thickness: inches or _____ Dia. _____ in. to _____ ft. depth Gauge No. 7	
sand & gravel w/little clay			54	65	10. Screen: Manufacturer's name _____ Johnson Type steel Dia. _____ Slot 3/16 Length 30 Set between 94 ft. and 124 ft. Gravel pack? <input checked="" type="checkbox"/> Size range of material 1/2 3/4 3/8	
good clean sand & gravel			65	74	11. Static water level: _____ mo./day/yr. 66 ft. below land surface Date 9-20-77	
sand & gravel w/clay streaks			74	83	12. Pumping level below land surfaces: 79 ft. after 2 hrs. pumping 600 g.p.m. _____ ft. after _____ hrs. pumping _____ g.p.m. Estimated maximum yield 1600 g.p.m.	
good clean sand & gravel			83	123	13. Water sample submitted: _____ mo./day/yr. <input checked="" type="checkbox"/> Yes _____ No Date 9-20-77	
shale			123		14. Well head completion: _____ Pitless adapter _____ Inches above grade	
					15. Well grouted? <input checked="" type="checkbox"/> With <input checked="" type="checkbox"/> Neat cement _____ Bentonite _____ Concrete _____ Depth: From 0 ft. to 10 ft.	
					16. Nearest source of possible contamination: ft. 1000 Direction East Type septic Well disinfected upon completion? <input checked="" type="checkbox"/> Yes _____ No _____	
					17. Pump: _____ Not installed Manufacturer's name _____ Model number _____ HP _____ Volts _____ Length of drop pipe _____ ft. capacity _____ g.p.m. Type: _____ Submersible _____ Turbine _____ Jet _____ Reciprocating _____ Centrifugal _____ Other _____	
					20. Water well contractor's certification: This well was drilled under my jurisdiction and this report is true to the best of my knowledge and belief. Rosencrantz-Bemis 134 Business name License No. Address Great Bend, Kansas 67530 Signed J. Kilgore Date 9-19-77 Authorized representative	
18. Elevation: Topography: _____ Hill _____ Slope <input checked="" type="checkbox"/> Upland _____ Valley		19. Remarks: (Use a second sheet if needed)				