

1 LOCATION OF WATER WELL:					Fraction	Section Number	Township Number	Range Number
County: McPherson					NE ¼ NE ¼ NE ¼	35	T 19 S	R 4


Distance and direction from nearest town or city street address of well if located within city?

2 miles West of McPherson, KS $\frac{1}{4}$ mile South

2	WATER WELL OWNER:	Richard Hassman	
	RR#, St. Address, Box # :	RR 2	Board of Agriculture, Division of Water Resources
	City, State, ZIP Code :	McPherson, KS 67460	Application Number:

3 LOCATE WELL'S LOCATION WITH AN "X" IN SECTION BOX:

4 DEPTH OF COMPLETED WELL.....143..... ft. ELEVATION:

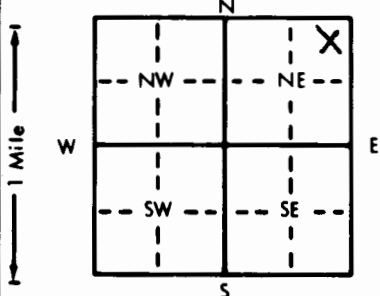

Depth(s) Groundwater Encountered 1. 87 ft. 2. 91 ft. 3. 97 ft.

WELL'S STATIC WATER LEVEL 87 ft. below land surface measured on mo/day/yr 8/7/87

Pump test data: Well water was 30 gpm: Well water was 90 ft. after 1 hours pumping 10 gpm

Est. Yield 30 gpm: Well water was 90 ft. after 1 hours pumping 10 gpm

Bore Hole Diameter 8 in. to 143 ft., and 143 in. to 143 ft.

WELL WATER TO BE USED AS:

1 <u>Domestic</u>	3 Feedlot	6 Oil field water supply	9 Dewatering	11 Injection well
2 <u>Irrigation</u>	4 Industrial	7 Lawn and garden only	10 Observation well	12 Other (Specify below)

Was a chemical/bacteriological sample submitted to Department? Yes.....No.....X....; If yes, mo/day/yr sample was submitted

Water Well Disinfected? Yes X No

5 TYPE OF BLANK CASING USED:		5 Wrought iron	8 Concrete tile	CASING JOINTS: <u>Glued</u>	Clamped
1 Steel	3 RMP (SR)	6 Asbestos-Cement	9 Other (specify below)	Welded	
2 PVC	4 ABS	7 Fiberglass		Threaded	

Blank casing diameter 5 in. to 133 ft., Dia in. to ft., Dia in. to ft.
Casing height above land surface 12 in., weight 2.91 lbs./ft. Wall thickness or gauge No. 265

TYPE OF SCREEN OR PERFORATION MATERIAL:			7 <u>PVC</u>	10 Asbestos-cement
1 Steel	3 Stainless steel	5 Fiberglass	8 RMP (SR)	11 Other (specify)
2 Brass	4 Galvanized steel	6 Concrete tile	9 ABS	12 None used (open hole)

SCREEN OR PERFORATION OPENINGS ARE:

1 Continuous slot	3 <u>Mill slot</u>	5 Gauzed wrapped	8 Saw cut	11 None (open hole)
2 Louvered shutter	4 Key punched	6 Wire wrapped	9 Drilled holes	
		7 Torch cut	10 Other (specify)	

SCREEN-PERFORATED INTERVALS:	From 128 . . . ft. to 138 . . . ft.,	From ft. to ft.
	From ft. to ft.,	From ft. to ft.
GRAVEL PACK INTERVALS:	From 20 . . . ft. to 143 . . . ft.,	From ft. to ft.
	From ft. to ft.,	From ft. to ft.

6 GROUT MATERIAL: 1 Neat cement 2 Cement grout 3 Bentonite 4 Other
Grout Intervals: From 5 ft. to 25 ft. From ft. to ft. From ft. to ft.

What is the nearest source of possible contamination:

1 Septic tank	4 <u>Lateral lines</u>	7 Pit privy	10 Livestock pens	14 Abandoned water well
2 Sewer lines	5 Cess pool	8 Sewage lagoon	11 Fuel storage	15 Oil well/Gas well
3 Watertight sewer lines	6 Seepage pit	9 Feedyard	12 Fertilizer storage	16 Other (specify below)
13 Insecticide storage				

Direction from well? South

How many feet? 2100

[illegible]

7 CONTRACTOR'S OR LANDOWNER'S CERTIFICATION: This water well was (1) constructed, (2) reconstructed, or (3) plugged under my jurisdiction and was completed on (mo/day/year) Aug. 7, 1987 and this record is true to the best of my knowledge and belief. Kansas Water Well Contractor's License No. 138 This Water Well Record was completed on (mo/day/yr) Aug. 11, 1987 under the business name of Peterson Irrigation, Inc. by (signature) [Signature]