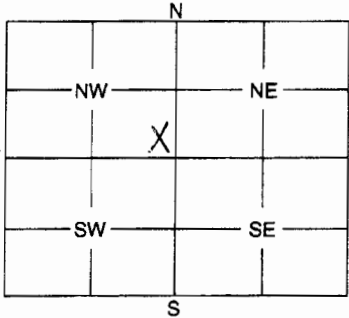


1	LOCATION OF WATER WELL:	Fraction	Section	Number	Township	Number	Range	Number
County: McPherson		SE ¼ SE ¼ NW ¼	29		19 S		4	EW

Distance and direction from nearest town or city street address of well if located within city?

NCRA Facility, Conway

2	WATER WELL OWNER: National Cooperative Refinery Assoc.	
RR #, St. Address, Box #: 1391 Ironhorse Road		Board of Agriculture, Division of Water Resources
City, State, ZIP Code : McPherson, KS 67460		Application Number:

3	MARK WELL'S LOCATION WITH AN "X" IN SECTION BOX:	4	DEPTH OF WELL 67.88 ft.
		WELL'S STATIC WATER LEVEL 39 ft.	
		WELL WAS USED AS:	
		1 Domestic 5 Public Water Supply 9 Dewatering 2 Irrigation 6 Oil Field Water Supply ● Monitoring Well 3 Feedlot 7 Domestic (Lawn & Garden) 11 Injection Well 4 Industrial 8 Air Conditioning 12 Other	
Was a chemical / bacteriological sample submitted to Department? Yes No ✓			
If yes, mo/day/yr sample was submitted			
Water Well Disinfected: Yes No ✓			

5	TYPE OF BLANK CASING USED:	
● Steel 3 RMP (SR) 5 Wrought 7 Fiberglass 9 Other (Specify below) 2 PVC 4 ABS 6 Asbestos-Cement 8 Concrete Tile		
Blank casing diameter 6 in.		Was casing pulled? Yes ✓ No If yes, how much 25'
Casing height above or below land surface n/a in.		

6	GROUT PLUG MATERIAL: ● Neat cement 2 Cement grout ● Bentonite 4 Other	
Grout Plug Intervals: From 3 ft. to 25 ft., From 25 ft. to 67 ft., From to ft.		
What is the nearest source of possible contamination:		
1 Septic tank 6 Seepage pit 11 Fuel storage 16 Other (specify below) 2 Sewer lines 7 Pit privy 12 Fertilizer storage 3 Watertight sewer lines 8 Sewage lagoon 13 Insecticide storage 4 Lateral lines 9 Feedyard 14 Abandoned water well 5 Cess pool 10 Livestock pens 15 Oil well/Gas well		
Direction from well? How many feet?		

FROM	TO	PLUGGING MATERIALS
0	3	Clay
3	25	Neat cement (13")
25	67	Bentonite (6")

OW-27C

GeoCore #525

7	CONTRACTOR'S OF LANDOWNER'S CERTIFICATION: This water well was plugged under my jurisdiction and was completed on (mo/day/year) 4/22/2008 and this record is true to the best of my knowledge and belief. Kansas Water Well Contractor's License No. 527 This Water Well Record was completed on (mo/day/year) 5/16/2008 under the business name of GeoCore, Inc.	
by (signature) <i>Dan Bell</i>		

INSTRUCTIONS: Use typewriter or ball point pen. Please press firmly and print clearly. Please fill in blanks, underline or circle the correct answers. Send top three copies to Kansas Department of Health and Environment, Bureau of Water, Geology Section, 1000 SW Jackson St., Ste. 420, Topeka, Kansas 66612-1367. Telephone: 785/296-5522. Send one to Water Well Owner and retain one for your records.