

**WATER WELL PLUGGING RECORD Form WWC-5P**
**KSA 82a-1212 ID NO.**

<b>1 LOCATION OF WATER WELL:</b> County: McPherson	Fraction NE ¼ NW ¼ NW ¼ NW ¼	Section Number 29	Township Number T 19 S	Range Number 4 <input type="checkbox"/> E <input checked="" type="checkbox"/> W
---	---------------------------------	----------------------	---------------------------	--

Street/Rural Address of Well Location; if unknown, distance & direction from nearest town or intersection: If at owner's address, check here ☐

~610' E of Limestone Rd & 7th Ave

**Global Positioning Systems (GPS) information:**

Latitude: 38.37654 (in decimal degrees)

Longitude: -97.79340 (in decimal degrees)

Elevation:

Datum: ☐ WGS84, ☒ NAD83, ☐ NAD27

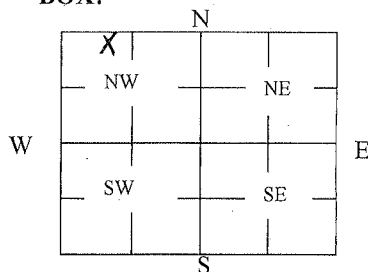
Collection Method:

☒ GPS unit (Make/Model: Extrex Legend

☐ Digital Map/Photo, ☐ Topographic Map, ☐ Land Survey

Est. Accuracy: ☐ < 3 m, ☐ 3-5 m, ☒ 5-15 m, ☐ > 15 m

**2 WATER WELL OWNER:** Williams MCFS  
RR#, St. Address, Box #: 1372 7th Avenue  
City, State ZIP Code: McPherson, KS 67460

**3 MARK WELL'S LOCATION WITH AN "X" IN SECTION BOX:**

**4 DEPTH OF WELL 53.2 ft.**

WELL'S STATIC WATER LEVEL 28.2 ft

WELL WAS USED AS:

☐ Domestic  
☐ Irrigation  
☐ Feedlot  
☐ Industrial

☐ Public Water Supply  
☐ Oil Field Water Supply  
☐ Domestic (Lawn & Garden)  
☐ Air Conditioning

☐ Dewatering  
☒ Monitoring  
☐ Injection Well  
☐ Other

Was a chemical/bacteriological sample submitted to Department? Yes ☐ No ☒

**5 TYPE OF BLANK CASING USED:**

☐ Steel  
☒ PVC

☐ RMP (SR)  
☐ ABS

☐ Wrought  
☐ Asbestos-Cement

☐ Fiberglass  
☐ Concrete Tile

☐ Other (Specify below)

Blank casing diameter 4 in. Was casing pulled? Yes ☒ No ☐ If yes, how much 28'

Casing height above or below land surface in.

**6 GROUT PLUG MATERIAL:** ☐ Neat cement ☒ Cement grout ☐ Bentonite ☐ Other

Grout Plug Intervals: From 3 ft. to 53.2 ft., From ft. to ft., From to ft.

What is the nearest source of possible contamination:

☐ Septic tank  
☐ Sewer lines  
☐ Watertight sewer lines  
☐ Lateral lines  
☐ Cess pool

☐ Seepage pit  
☐ Pit privy  
☐ Sewage lagoon  
☐ Feedyard  
☐ Livestock pens

☐ Fuel Storage  
☐ Fertilizer storage  
☐ Insecticide storage  
☐ Abandoned water well  
☐ Oil well/Gas well

☒ Other (specify below)  
LP Storage Cavern

Direction from well? S  
How many feet? ~500

FROM	TO	PLUGGING MATERIALS	FROM	TO	PLUGGING MATERIALS
0	3	Soil			
3	28	Cement grout (11")			TNF7
28	53.2	Cement grout (4")			

**7 CONTRACTOR'S OR LANDOWNER'S CERTIFICATION:** This water well was plugged under my jurisdiction and was completed on (mo/day/year) 4/10/2012 and this record is true to the best of my knowledge and belief. Kansas Water Well Contractor's License No. 527. This Water Well Record was completed on (mo/day/year) 4/20/2012 under the business name of GeoCore Inc. by (signature) *Dele Bell*

**INSTRUCTIONS:** Use typewriter or ballpoint pen. Please press firmly and print clearly. Please fill in blanks, underline or circle the correct answers. Send top three copies to Kansas Department of Health and Environment, Bureau of Water, Geology Section, 1000 SW Jackson St., Ste. 420, Topeka, Kansas 66612-1367. Telephone: 785/296-5524. Send one to Water Well Owner and retain one for your records. Visit us at <http://www.kdheks.gov/waterwell/index.html>.

Check one: ☐ White Copy ☐ Blue Copy ☐ Pink Copy