

WATER WELL PLUGGING RECORD Form WWC-5P

KSA 82a-1212

ID NO.

1 LOCATION OF WATER WELL: Fraction Section Number Township Number Range Number
 County: McPherson NE 1/4 SE 1/4 NE 1/4 NE 1/4 32 T 19 S 4 ☐ E ☒ W

Street/Rural Address of Well Location; if unknown, distance & direction from nearest town or intersection: If at owner's address, check here ☐

770' S & 90' W of 8th Ave. & Kiowa Rd.

Global Positioning Systems (GPS) information:

Latitude: 38.36030 (in decimal degrees)

Longitude: 97.77780 (in decimal degrees)

Elevation:

Datum: ☒ WGS84, ☐ NAD83, ☐ NAD27

Collection Method:


☐ GPS unit (Make/Model):

☐ Digital Map/Photo, ☐ Topographic Map, ☐ Land Survey

Est. Accuracy: ☐ < 3 m, ☐ 3-5 m, ☐ 5-15 m, ☐ > 15 m

2 WATER WELL OWNER: Williams MCFS
 RR#, St. Address, Box #: 1372 7th Ave.
 City, State ZIP Code: McPherson, KS 67460

3 MARK WELL'S LOCATION WITH AN "X" IN SECTION BOX:

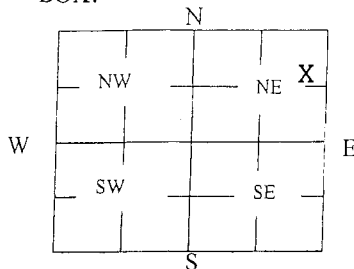

4 DEPTH OF WELL 138.37 ft.

WELL'S STATIC WATER LEVEL 33.62 ft btoc

WELL WAS USED AS:

☐ Domestic
☐ Irrigation
☐ Feedlot
☐ Industrial

☐ Public Water Supply
☐ Oil Field Water Supply
☐ Domestic (Lawn & Garden)
☐ Air Conditioning

☐ Dewatering
☒ Monitoring
☐ Injection Well
☐ Other

Was a chemical/bacteriological sample submitted to Department? Yes ☐ No ☒

5 TYPE OF BLANK CASING USED:

☐ Steel ☐ RMP (SR) ☐ Wrought ☐ Fiberglass ☐ Other (Specify below)
☒ PVC ☐ ABS ☐ Asbestos-Cement ☐ Concrete Tile

Blank casing diameter 4 in. Was casing pulled? Yes ☒ No ☐ If yes, how much 18'
 Casing height above or below land surface in.

6 GROUT PLUG MATERIAL: ☒ Neat cement ☐ Cement grout ☐ Bentonite ☐ Other

Grout Plug Intervals: From 3 ft. to 138.37 ft., From ft. to ft., From to ft.

What is the nearest source of possible contamination:

☐ Septic tank ☐ Seepage pit ☒ Fuel Storage ☐ Other (specify below)
☐ Sewer lines ☐ Pit privy ☐ Fertilizer storage
☐ Watertight sewer lines ☐ Sewage lagoon ☐ Insecticide storage
☐ Lateral lines ☐ Feedyard ☐ Abandoned water well Direction from well? W
☐ Cess pool ☐ Livestock pens ☐ Oil well/Gas well How many feet? 200

FROM	TO	PLUGGING MATERIALS	FROM	TO	PLUGGING MATERIALS
0	3	Native soil (11")			
3	35	Neat cement (11")			TS1
35	138.37	Neat cement (4")			

7 CONTRACTOR'S OR LANDOWNER'S CERTIFICATION: This water well was plugged under my jurisdiction and was completed on (mo/day/year) 10/1/2012 and this record is true to the best of my knowledge and belief. Kansas Water Well Contractor's License No. 527. This Water Well Record was completed on (mo/day/year) 10/19/2012 under the business name of GeoCore Inc. by (signature) Dale Lipp

INSTRUCTIONS: Use typewriter or ballpoint pen. Please press firmly and print clearly. Please fill in blanks, underline or circle the correct answers. Send top three copies to Kansas Department of Health and Environment, Bureau of Water, Geology Section, 1000 SW Jackson St., Ste. 420, Topeka, Kansas 66612-1367. Telephone: 785/296-5524. Send one to Water Well Owner and retain one for your records. Visit us at <http://www.kdheks.gov/waterwell/index.html>.

Check one: ☐ White Copy ☐ Blue Copy ☐ Pink Copy