

WATER WELL PLUGGING RECORD Form WWC-5P KSA 82a-1212 ID NO.

1 LOCATION OF WATER WELL: County: McPherson	Fraction NE ¼ NE ¼ SE ¼ SE ¼	Section Number 29	Township Number T 19 S	Range Number 4 ☐ E ☒ W
---	---------------------------------	----------------------	---------------------------	--


Street/Rural Address of Well Location; if unknown, distance & direction from nearest town or intersection: If at owner's address, check here ☐

~1030' N & 130' W of Kiowa Rd. & 8th Ave.

2 WATER WELL OWNER: Williams MCFS, LLC
RR#, St. Address, Box #: 839 Kiowa Road
City, State ZIP Code: McPherson, KS 67460

Global Positioning Systems (GPS) information:
Latitude: 38.36517 (in decimal degrees)
Longitude: 97.77794 (in decimal degrees)
Elevation:
Datum: ☒ WGS84, ☐ NAD83, ☐ NAD27
Collection Method:
☐ GPS unit (Make/Model: _____)
☒ Digital Map/Photo, ☐ Topographic Map, ☐ Land Survey
Est. Accuracy: ☐ < 3 m, ☒ 3-5 m, ☐ 5-15 m, ☐ > 15 m

3 MARK WELL'S LOCATION WITH AN "X" IN SECTION BOX:

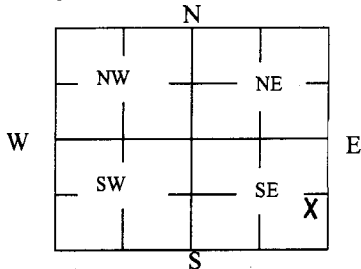

4 DEPTH OF WELL 138.75 ft.

WELL'S STATIC WATER LEVEL 43.9 ft

WELL WAS USED AS:

- | | | |
|-------------------------------------|---|--|
| ☐ Domestic | ☐ Public Water Supply | ☐ Dewatering |
| ☐ Irrigation | ☐ Oil Field Water Supply | ☒ Monitoring |
| ☐ Feedlot | ☐ Domestic (Lawn & Garden) | ☐ Injection Well |
| ☐ Industrial | ☐ Air Conditioning | ☐ Other _____ |

Was a chemical/bacteriological sample submitted to Department? Yes ☐ No ☒

5 TYPE OF BLANK CASING USED:

- ☐ Steel ☐ RMP (SR) ☐ Wrought ☐ Fiberglass ☐ Other (Specify below) _____
☒ PVC ☐ ABS ☐ Asbestos-Cement ☐ Concrete Tile

Blank casing diameter 4 in. Was casing pulled? Yes ☒ No ☐ If yes, how much 6' - Drilled to 25'
 Casing height above or below land surface _____ in.

6 GROUT PLUG MATERIAL:

- ☒ Neat cement ☐ Cement grout ☐ Bentonite ☐ Other _____

Grout Plug Intervals: From 3 ft. to 139 ft., From _____ ft. to _____ ft., From _____ to _____ ft.

What is the nearest source of possible contamination:

- | | | | |
|---|---|---|--|
| ☐ Septic tank | ☐ Seepage pit | ☐ Fuel Storage | ☐ Other (specify below) _____
Direction from well? _____
How many feet? _____ |
| ☐ Sewer lines | ☐ Pit privy | ☐ Fertilizer storage | |
| ☐ Watertight sewer lines | ☐ Sewage lagoon | ☐ Insecticide storage | |
| ☐ Lateral lines | ☐ Feedyard | ☐ Abandoned water well | |
| ☐ Cess pool | ☐ Livestock pens | ☐ Oil well/Gas well | |

FROM	TO	PLUGGING MATERIALS	FROM	TO	PLUGGING MATERIALS
0	3	Native soil (9")			
3	25	Neat cement (9")			TX4
25	139	Neat cement (4")			

7 CONTRACTOR'S OR LANDOWNER'S CERTIFICATION: This water well was plugged under my jurisdiction and was completed on (mo/day/year) 10/23/2012 and this record is true to the best of my knowledge and belief. Kansas Water Well Contractor's License No. 527. This Water Well Record was completed on (mo/day/year) 12/14/12 under the business name of GeoCore Inc. by (signature) *GeoCore Inc.*

INSTRUCTIONS: Use typewriter or ballpoint pen. Please press firmly and print clearly. Please fill in blanks, underline or circle the correct answers. Send top three copies to Kansas Department of Health and Environment, Bureau of Water, Geology Section, 1000 SW Jackson St., Ste. 420, Topeka, Kansas 66612-1367. Telephone: 785/296-5524. Send one to Water Well Owner and retain one for your records. Visit us at <http://www.kdheks.gov/waterwell/index.html>.

Check one: ☐ White Copy ☐ Blue Copy ☐ Pink Copy