

USE TYPEWRITER OR BALL POINT PEN-PRESS FIRMLY, PRINT CLEARLY.


WATER WELL RECORD
KSA 82a-1201-1215

Kansas Department of Health and Environment-Division of Environment (Water well Contractors) Topeka, Kansas 66620

TRIBUNE

1. Location of well: County Greeley Fraction SW 1/4 NW 1/4 NW 1/4 Section number 19 Township number T 19 S R 40 E Range number 40 EN

2. Distance and direction from nearest town or city: 5S, 2W, 1/4S 3. Owner of well: Paul Myers
Street address of well location if in city: of Tribune, KS R.R. or street: Tribune, KS 67879
City, state, zip code:

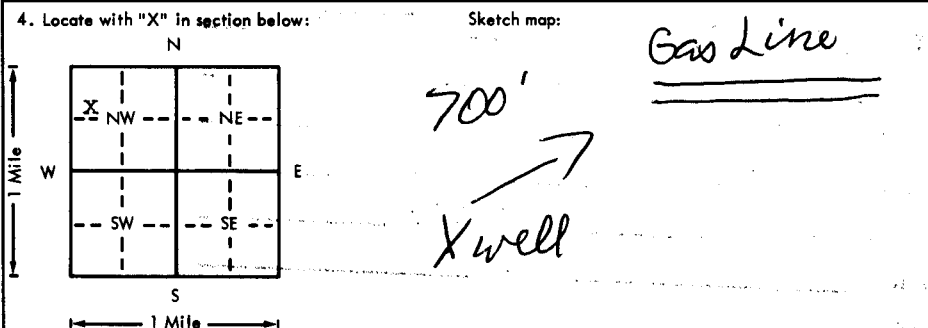

6. Bore hole dia. 9 in. Completion date _____
Well depth 125 ft. 1-13-76

7. Cable tool Rotary Driven Dug
 Hollow rod Jetted Bored Reverse rotary

8. Use: Domestic Public supply Industry
 Irrigation Air conditioning Stock
 Lawn Oil field water Other

9. Casing: Material Plas Height: Above or below
Threaded Welded Surface 12 in.
RMP PVC Weight 1.8 lbs./ft.
Dia. 5 in. to 105 ft. depth Wall Thickness: inches or
Dia. _____ in. to _____ ft. depth Gauge No. 250

5. Type and color of material	From	To
Clay	0	18
Sd rock	18	28
Clay	28	31
Sd coarse	31	42
Gyp rock	42	56
Sd & gravel	56	67
Clay	67	70
Sd coarse	70	80
Sd rock	80	83
Clay yellow	83	92
Med sd clay	92	97
Clay sdy	97	110
Sd coarse	110	115
Sd rock H	115	119
Sd coarse	119	123
Sd rock H (Use a second sheet if needed)	123	125

10. Screen: Manufacturer's name Jess & Lowell

Type RMP Dia. 5 in.
Slot gauge 1/16 Length 20 ft.
Set between 105 ft. and 125 ft.
ft. and _____ ft.
Gravel pack? yes Size range of material 1/2-1/8

11. Static water level: _____ mo./day/yr.
117 ft. below land surface Date 1-13-76

12. Pumping level below land surfaces: NA
_____ ft. after _____ hrs. pumping _____ g.p.m.
_____ ft. after _____ hrs. pumping _____ g.p.m.
Estimated maximum yield _____ g.p.m.

13. Water sample submitted: _____ mo./day/yr.
Yes No Date _____

14. Well head completion: NA
_____ Pitless adapter _____ Inches above grade

15. Well grouted? yes
With: Neat cement Bentonite Concrete
Depth: From 0 ft. to 15 ft.

16. Nearest source of possible contamination: Gas
ft. 700 Direction NE Type Line
Well disinfected upon completion? Yes No

17. Pump: Not installed
Manufacturer's name _____
Model number _____ HP _____ Volts _____
Length of drop pipe _____ ft. capacity _____ g.p.m.
Type:
 Submersible Turbine
 Jet Reciprocating
 Centrifugal Other

18. Elevation: _____
19. Remarks: Clay yellow 125
Well not finished by us; finished by Davison Well Service at Tribune, KS.
Topography:
 Hill
 Slope
 Upland
 Valley
76 PO 3625

20. Water well contractor's certification:
This well was drilled under my jurisdiction and this report is true to the best of my knowledge and belief.
Weishaar Drilling 232
Business name _____ License No. _____
Address Scott, City, KS 67871
Signed [Signature] Date 2-11-76
Authorized representative

T
R
E
S
E
C
19
42
19
S
E
1/4
1/4
1/4
1/4