


**WATER WELL RECORD Form WWC-5 KSA 82a-1212**


Distance and direction from nearest town or city street address of well if located within city?  
4 1/2 S - 1 West

2 WATER WELL OWNER: Clark Sola  
 RR#, St. Address, Box #: 2342 Heather Hill Blvd No Board of Agriculture, Division of Water Resources  
 City, State, ZIP Code: Cincinnati Ohio 45244 Application Number:

3 LOCATE WELL'S LOCATION WITH AN "X" IN SECTION BOX:

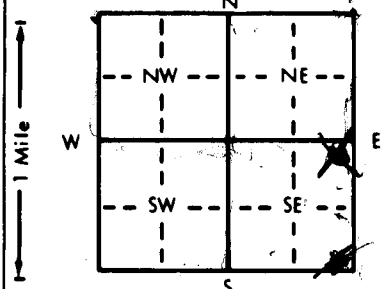

4 DEPTH OF COMPLETED WELL: 110 ft. ELEVATION:

Depth(s) Groundwater Encountered 1. .... ft. 2. .... ft. 3. .... ft.  
 WELL'S STATIC WATER LEVEL: 3 ft. below land surface measured on mo/day/yr 11/1/94  
 Pump test data: Well water was ..... ft. after ..... hours pumping ..... gpm  
 Est. Yield ..... gpm: Well water was ..... ft. after ..... hours pumping ..... gpm  
 Bore Hole Diameter ..... in. to ..... ft., and ..... in. to ..... ft.  
 WELL WATER TO BE USED AS:  
 5 Public water supply     8 Air conditioning     11 Injection well  
 2 Domestic     3 Feedlot     6 Oil field water supply     9 Dewatering     12 Other (Specify below)  
 2 Irrigation     4 Industrial     7 Lawn and garden only     10 Monitoring well  
 Was a chemical/bacteriological sample submitted to Department? Yes ..... No  .....; If yes, mo/day/yr sample was submitted  
 Water Well Disinfected? Yes  No

5 TYPE OF BLANK CASING USED:  
 Steel    3 RMP (SR)    5 Wrought iron    8 Concrete tile    CASING JOINTS: Glued ..... Clamped .....  
 2 PVC    4 ABS    6 Asbestos-Cement    9 Other (specify below)    Welded .....  
 7 Fiberglass    Threaded .....

Blank casing diameter: 6 in. to 110 ft., Dia ..... in. to ..... ft., Dia ..... in. to ..... ft.  
 Casing height above land surface: 36 in., weight ..... lbs./ft. Wall thickness or gauge No. ....

TYPE OF SCREEN OR PERFORATION MATERIAL:  
 Steel    3 Stainless steel    5 Fiberglass    7 PVC    10 Asbestos-cement  
 2 Brass    4 Galvanized steel    6 Concrete tile    8 RMP (SR)    11 Other (specify) .....  
 9 ABS    12 None used (open hole)

SCREEN OR PERFORATION OPENINGS ARE:  
 1 Continuous slot    3 Mill slot    5 Gauzed wrapped    8 Saw cut    11 None (open hole)  
 2 Louvered shutter    4 Key punched    6 Wire wrapped    9 Drilled holes  
 7 Torch cut    10 Other (specify) .....

SCREEN-PERFORATED INTERVALS: From ..... ft. to ..... ft., From ..... ft. to ..... ft.  
 GRAVEL PACK INTERVALS: From ..... ft. to ..... ft., From ..... ft. to ..... ft.

6 GROUT MATERIAL: 1 Neat cement    2 Cement grout    3 Bentonite    4 Other .....  
 Grout Intervals: From 3 ft. to 6 ft., From ..... ft. to ..... ft., From ..... ft. to ..... ft.

What is the nearest source of possible contamination: 1 1/2 Miles  
 1 Septic tank    4 Lateral lines    7 Pit privy    10 Livestock pens    14 Abandoned water well  
 2 Sewer lines    5 Cess pool    8 Sewage lagoon    11 Fuel storage    15 Oil well/Gas well  
 3 Watertight sewer lines    6 Seepage pit    9 Feedyard    12 Fertilizer storage    16 Other (specify below)  
 13 Insecticide storage

Direction from well? How many feet?

FROM	TO	LITHOLOGIC LOG	FROM	TO	PLUGGING INTERVALS
			110	100	Sand
			100	9	Clay
			9	3	Cement Grout
			3	0	Top Soil

7 CONTRACTOR'S OR LANDOWNER'S CERTIFICATION: This water well was (1) constructed, (2) reconstructed, or (3) plugged under my jurisdiction and was completed on (mo/day/year) 11-1-94 and this record is true to the best of my knowledge and belief. Kansas Water Well Contractor's License No. None This Water Well Record was completed on (mo/day/yr) 11-2-94 under the business name of \_\_\_\_\_ by (signature) RELOGT (Kenan T)