


1 LOCATION OF WATER WELL: County: GREELEY Fraction: NW 1/4 NW 1/4 NE 1/4 Section Number: 22 Township Number: T 19 S Range Number: R 41 E/W

Distance and direction from nearest town or city street address of well if located within city?
4 WEST 5 1/2 SOUTH 1/2 WEST OF TRIBUNE, KS

2 WATER WELL OWNER: WAIVE WINTER
 RR#, St. Address, Box # : _____ Board of Agriculture, Division of Water Resources
 City, State, ZIP Code: TRIBUNE, KS 67879 Application Number: _____

3 LOCATE WELL'S LOCATION WITH AN "X" IN SECTION BOX:

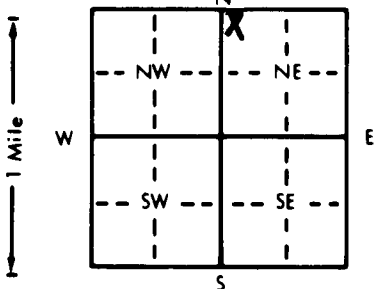

4 DEPTH OF COMPLETED WELL: 180 ft. ELEVATION: 3420

Depth(s) Groundwater Encountered: 1. 149 ft. 2. _____ ft. 3. _____ ft.
 WELL'S STATIC WATER LEVEL: 149 ft. below land surface measured on mo/day/yr: 5-13-91
 Pump test data: Well water was 1.73 ft. after 2 hours pumping 20 gpm
 Est. Yield 25 gpm: Well water was _____ ft. after _____ hours pumping _____ gpm
 Bore Hole Diameter: 8 in. to _____ ft., and _____ in. to _____ ft.
 WELL WATER TO BE USED AS:
 1 Domestic 3 Feedlot 6 Oil field water supply 9 Dewatering 11 Injection well
 2 Irrigation 4 Industrial 7 Lawn and garden only 10 Monitoring well 12 Other (Specify below) _____
 Was a chemical/bacteriological sample submitted to Department? Yes _____ No X; If yes, mo/day/yr sample was submitted _____
 Water Well Disinfected? Yes X No _____

5 TYPE OF BLANK CASING USED:
 1 Steel 3 RMP (SR) 5 Wrought iron 8 Concrete tile CASING JOINTS: Glued _____ Clamped _____
 2 PVC 4 ABS 6 Asbestos-Cement 9 Other (specify below) _____ Welded _____
 7 Fiberglass _____ Threaded _____
 Blank casing diameter: 5 in. to 160 ft., Dia _____ in. to _____ ft., Dia _____ in. to _____ ft.
 Casing height above land surface: _____ in., weight _____ lbs./ft. Wall thickness or gauge No. Sch 40

TYPE OF SCREEN OR PERFORATION MATERIAL:
 1 Steel 3 Stainless steel 5 Fiberglass 7 PVC 10 Asbestos-cement
 2 Brass 4 Galvanized steel 6 Concrete tile 8 RMP (SR) 11 Other (specify) _____
 12 None used (open hole) _____

SCREEN OR PERFORATION OPENINGS ARE:
 1 Continuous slot 3 Mill slot 5 Gauzed wrapped 8 Saw cut 11 None (open hole)
 2 Louvered shutter 4 Key punched 6 Wire wrapped 9 Drilled holes
 7 Torch cut 10 Other (specify) _____

SCREEN-PERFORATED INTERVALS: From 160 ft. to 180 ft., From _____ ft. to _____ ft.
 From _____ ft. to _____ ft., From _____ ft. to _____ ft.
 GRAVEL PACK INTERVALS: From 25 ft. to 180 ft., From _____ ft. to _____ ft.
 From _____ ft. to _____ ft., From _____ ft. to _____ ft.

6 GROUT MATERIAL: 1 Neat cement 2 Cement grout 3 Bentonite 4 Other _____
 Grout Intervals: From 5 ft. to 25 ft., From _____ ft. to _____ ft., From _____ ft. to _____ ft.

What is the nearest source of possible contamination:
 1 Septic tank 4 Lateral lines 7 Pit privy 10 Livestock pens 14 Abandoned water well
 2 Sewer lines 5 Cess pool 8 Sewage lagoon 11 Fuel storage 15 Oil well/Gas well
 3 Watertight sewer lines 6 Seepage pit 9 Feedyard 12 Fertilizer storage 16 Other (specify below) _____
 13 Insecticide storage _____

Direction from well? WEST How many feet? 20'

FROM	TO	LITHOLOGIC LOG	FROM	TO	PLUGGING INTERVALS
0	33	TOPSOIL & LIMESTONE	173	180	SHALE
33	49	SAND (FINE)			
49	62	SAND (medium)			
62	69	CLAY (white)			
69	82	SAND & GRAVEL			
82	86	CLAY			
86	93	SAND (medium)			
93	107	CLAY (brown)			
107	120	SAND (medium)			
120	125	CLAY			
125	132	SAND			
132	148	CEMENTED SAND (HARD)			
148	154	CLAY			
154	169	SAND			
169	173	YELLOW CLAY			

7 CONTRACTOR'S OR LANDOWNER'S CERTIFICATION: This water well was (1) constructed, (2) reconstructed, or (3) plugged under my jurisdiction and was completed on (mo/day/year) 5-15-91 and this record is true to the best of my knowledge and belief. Kansas Water Well Contractor's License No. 473 This Water Well Record was completed on (mo/day/yr) 5-29-91 under the business name of TYLER WATER WELL SERVICE by (signature) [Signature]

INSTRUCTIONS: Use typewriter or ball point pen. PLEASE PRESS FIRMLY and PRINT clearly. Please fill in blanks, underline or circle the correct answers. Send top three copies to Kansas Department of Health and Environment, Bureau of Water, Topeka, Kansas 66620-7320. Telephone: 913-296-5545. Send one to WATER WELL OWNER and retain one for your records.