


1 LOCATION OF WATER WELL: County: Greeley Fraction: NW 1/4 NE 1/4 NE 1/4 Section Number: 15 Township Number: T 19 S Range Number: R 42 E/W

Distance and direction from nearest town or city street address of well if located within city?  
9 Miles West, 4 Miles South, 1 Mile West of Tribune

2 WATER WELL OWNER: Gene Moritz  
 RR#, St. Address, Box # : Box 674  
 City, State, ZIP Code : Tribune, KS 67879  
 Board of Agriculture, Division of Water Resources  
 Application Number:

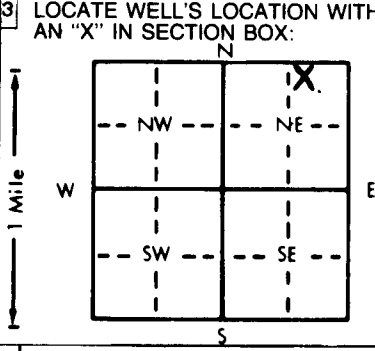

4 DEPTH OF COMPLETED WELL: 85' ft. ELEVATION: \_\_\_\_\_  
 Depth(s) Groundwater Encountered 1. \_\_\_\_\_ ft. 2. \_\_\_\_\_ ft. 3. \_\_\_\_\_ ft.  
 WELL'S STATIC WATER LEVEL: 53' ft. below land surface measured on mo/day/yr 06/06/90  
 Pump test data: Well water was \_\_\_\_\_ ft. after \_\_\_\_\_ hours pumping \_\_\_\_\_ gpm  
 Est. Yield \_\_\_\_\_ gpm: Well water was \_\_\_\_\_ ft. after \_\_\_\_\_ hours pumping \_\_\_\_\_ gpm  
 Bore Hole Diameter: 10" in. to 85' ft., and \_\_\_\_\_ in. to \_\_\_\_\_ ft.  
 WELL WATER TO BE USED AS:  
 1 Domestic     3 Feedlot     6 Oil field water supply     9 Dewatering     12 Other (Specify below)  
 2 Irrigation     4 Industrial     7 Lawn and garden only     10 Monitoring well  
 Was a chemical/bacteriological sample submitted to Department? Yes \_\_\_\_\_ No X; If yes, mo/day/yr sample was submitted \_\_\_\_\_  
 Water Well Disinfected? Yes X No \_\_\_\_\_

5 TYPE OF BLANK CASING USED:  
 1 Steel     3 RMP (SR)     5 Wrought iron     8 Concrete tile    CASING JOINTS: Glued X Clamped \_\_\_\_\_  
 2 PVC     4 ABS     6 Asbestos-Cement     9 Other (specify below)    Welded \_\_\_\_\_  
 5 \_\_\_\_\_     7 Fiberglass    \_\_\_\_\_    Threaded \_\_\_\_\_  
 Blank casing diameter: 5" in. to 65' ft., Dia \_\_\_\_\_ in. to \_\_\_\_\_ ft., Dia \_\_\_\_\_ in. to \_\_\_\_\_ ft.  
 Casing height above land surface: 2' in., weight \_\_\_\_\_ lbs./ft. Wall thickness or gauge No. \_\_\_\_\_  
 TYPE OF SCREEN OR PERFORATION MATERIAL:  
 1 Steel     3 Stainless steel     5 Fiberglass     7 PVC     10 Asbestos-cement  
 2 Brass     4 Galvanized steel     6 Concrete tile     8 RMP (SR)     11 Other (specify) \_\_\_\_\_  
 12 None used (open hole)  
 SCREEN OR PERFORATION OPENINGS ARE:  
 1 Continuous slot     3 Mill slot     5 Gauzed wrapped     8 Saw cut     11 None (open hole)  
 2 Louvered shutter     4 Key punched     6 Wire wrapped     9 Drilled holes  
 7 Torch cut     10 Other (specify) \_\_\_\_\_  
 SCREEN-PERFORATED INTERVALS: From 65' ft. to 85' ft., From \_\_\_\_\_ ft. to \_\_\_\_\_ ft.  
 From \_\_\_\_\_ ft. to \_\_\_\_\_ ft., From \_\_\_\_\_ ft. to \_\_\_\_\_ ft.  
 GRAVEL PACK INTERVALS: From 20' ft. to 85' ft., From \_\_\_\_\_ ft. to \_\_\_\_\_ ft.  
 From \_\_\_\_\_ ft. to \_\_\_\_\_ ft., From \_\_\_\_\_ ft. to \_\_\_\_\_ ft.

6 GROUT MATERIAL:  1 Neat cement     2 Cement grout     3 Bentonite     4 Other \_\_\_\_\_  
 Grout intervals: From 0' ft. to 20' ft., From \_\_\_\_\_ ft. to \_\_\_\_\_ ft., From \_\_\_\_\_ ft. to \_\_\_\_\_ ft.  
 What is the nearest source of possible contamination:  
 1 Septic tank     4 Lateral lines     7 Pit privy     10 Livestock pens     14 Abandoned water well  
 2 Sewer lines     5 Cess pool     8 Sewage lagoon     11 Fuel storage     15 Oil well/Gas well  
 3 Watertight sewer lines     6 Seepage pit     9 Feedyard     12 Fertilizer storage     16 Other (specify below)  
 13 Insecticide storage  
 Direction from well? South How many feet? 50'

FROM	TO	LITHOLOGIC LOG	FROM	TO	PLUGGING INTERVALS
0'	3'	Top Soil			
3'	18'	Sandy Clay			
18'	26'	Tan Clay			
26'	37'	Coarse Sand, Small Gravel			
37'	42'	Yellow and White Rock, Medium Hard			
42'	85'	Yellow and White Clay, Soft			
	85'	Total Depth			

7 CONTRACTOR'S OR LANDOWNER'S CERTIFICATION: This water well was  (1) constructed  (2) reconstructed, or  (3) plugged under my jurisdiction and was completed on (mo/day/year) 06/06/90 and this record is true to the best of my knowledge and belief. Kansas Water Well Contractor's License No. 518 514 This Water Well Record was completed on (mo/day/yr) 06/27/90 under the business name of Miller Gearhead & Pump Repair, Inc. by (signature) Eric Miller

INSTRUCTIONS: Use typewriter or ball point pen. PLEASE PRESS FIRMLY and PRINT clearly. Please fill in blanks, underline or circle the correct answers. Send top three copies to Kansas Department of Health and Environment, Bureau of Water, Topeka, Kansas 66620-7320. Telephone: 913-296-5545. Send one to WATER WELL OWNER and retain one for your records.