


1] LOCATION OF WATER WELL: County: **Greeley** Fraction **NW 1/4 NW 1/4 SW 1/4** Section Number **12** Township Number **T 19 S** Range Number **R 43 EW**

Distance and direction from nearest town or city street address of well if located within city?
15 west 3 1/2 south of Tribune, Ks

2] WATER WELL OWNER: **Steve Schmidt**
 RR#, St. Address, Box # :
 City, State, ZIP Code : **Tribune, Ks 67879** Board of Agriculture, Division of Water Resources
 Application Number:

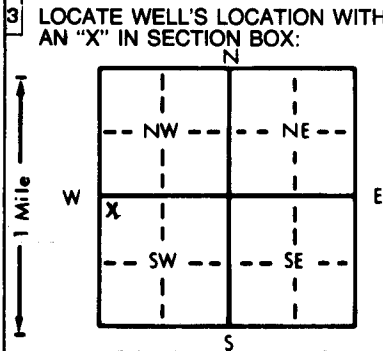

4] DEPTH OF COMPLETED WELL: **77** ft. ELEVATION: **3700**
 Depth(s) Groundwater Encountered 1. **51** ft. 2. ft. 3. ft.
 WELL'S STATIC WATER LEVEL **51** ft. below land surface measured on mo/day/yr **7-1-89**
 Pump test data: Well water was **60** ft. after **2** hours pumping **12** gpm
 Est. Yield **20** gpm Well water was ft. after hours pumping gpm
 Bore Hole Diameter **8** in. to **77** ft., and in. to ft.
 WELL WATER TO BE USED AS:
 1 Domestic 3 Feedlot 6 Oil field water supply 9 Dewatering 12 Other (Specify below)
 2 Irrigation 4 Industrial 7 Lawn and garden only 10 Monitoring well
 Was a chemical/bacteriological sample submitted to Department? Yes No **X**; If yes, mo/day/yr sample was sub-
 mitted Water Well Disinfected? Yes **X** No

5] TYPE OF BLANK CASING USED:
 1 Steel 3 RMP (SR) 5 Wrought iron 8 Concrete tile CASING JOINTS: Glued **X** Clamped
 2 PVC 4 ABS 6 Asbestos-Cement 9 Other (specify below) Welded
 7 Fiberglass Threaded
 Blank casing diameter **5** in. to **55** ft., Dia in. to ft., Dia in. to ft.
 Casing height above land surface **18** in., weight lbs./ft. Wall thickness or gauge No. **Sch 200**
 TYPE OF SCREEN OR PERFORATION MATERIAL:
 1 Steel 3 Stainless steel 5 Fiberglass 7 PVC 10 Asbestos-cement
 2 Brass 4 Galvanized steel 6 Concrete tile 9 ABS 11 Other (specify)
 12 None used (open hole)
 SCREEN OR PERFORATION OPENINGS ARE:
 1 Continuous slot 3 Mill slot 5 Gauzed wrapped 8 Saw cut 11 None (open hole)
 2 Louvered shutter 4 Key punched 6 Wire wrapped 9 Drilled holes
 7 Torch cut 10 Other (specify)
 SCREEN-PERFORATED INTERVALS: From **55** ft. to **77** ft., From ft. to ft.
 From ft. to ft., From ft. to ft.
 GRAVEL PACK INTERVALS: From **40** ft. to **77** ft., From ft. to ft.
 From ft. to ft., From ft. to ft.

6] GROUT MATERIAL: 1 Neat cement 2 Cement grout 3 Bentonite 4 Other
 Grout intervals: From **10** ft. to **30** ft., From ft. to ft., From ft. to ft.
 What is the nearest source of possible contamination:
 1 Septic tank 4 Lateral lines 7 Pit privy 10 Livestock pens 14 Abandoned water well
 2 Sewer lines 5 Cess pool 8 Sewage lagoon 11 Fuel storage 15 Oil well/Gas well
 3 Watertight sewer lines 6 Seepage pit 9 Feedyard 12 Fertilizer storage 16 Other (specify below)
 13 Insecticide storage
 Direction from well? **west** How many feet? **120**

FROM	TO	LITHOLOGIC LOG	FROM	TO	PLUGGING INTERVALS
0	5	top soil			
5	16	limestone			
16	20	limestone			
20	33	sand & cemented sand			
33	35,	sand			
35-	49	clay			
49	62	clay			
62	66	sand			
66	75	sand			
75	77	shale			

7] CONTRACTOR'S OR LANDOWNER'S CERTIFICATION: This water well was (1) constructed, (2) reconstructed, or (3) plugged under my jurisdiction and was completed on (mo/day/year) **7-1-89** and this record is true to the best of my knowledge and belief. Kansas Water Well Contractor's License No. **473** This Water Well Record was completed on (mo/day/yr) **7-4-89** under the business name of **Tyler Water Well Service** by (signature) *Paul E. J...*