

1 LOCATION OF WATER WELL:	Fraction	Section Number	Township Number	Range Number
County: McPherson	NW ¼ NW ¼ SW ¼	23	T 19 S	R 5 E/W

Distance and direction from nearest town or city street address of well if located within city?

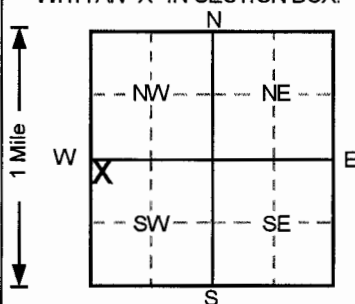
2 1/2 mile W, 1/2 mile N of Conway, E side of road2 WATER WELL OWNER: **Mid America Pipeline Company**RR#, St. Address, Box # : **1800 South Baltimore Ave.**

Board of Agriculture, Division of Water Resources

City, State, ZIP Code : **Tulsa, OK 74119**

Application Number:

3 LOCATE WELL'S LOCATION WITH AN "X" IN SECTION BOX:

4 DEPTH OF COMPLETED WELL **27** ft. ELEVATION:

Depth(s) Groundwater Encountered 1. ft. 2. ft. 3. ft.

WELL'S STATIC WATER LEVEL **17.87** ft. below land surface measured on mo/day/yr **10/5/95**Pump test data: Well water was **NA** ft. after hours pumping gpmEst. Yield **NA** gpm: Well water was ft. after hours pumping gpmBore Hole Diameter **8** in. to **30** ft. and in. to ft.

WELL WATER TO BE USED AS: 5 Public water supply 8 Air conditioning 11 Injection well

1 Domestic 3 Feedlot 6 Oil field water supply 9 Dewatering 12 Other (Specify below)

2 Irrigation 4 Industrial 7 Lawn and garden only **10** Monitoring wellWas a chemical/bacteriological sample submitted to Department? Yes.....No **✓**.....; If yes, mo/day/yr sample was submittedWater Well Disinfected? Yes No **✓**

5 TYPE OF BLANK CASING USED:

5 Wrought iron

8 Concrete tile

CASING JOINTS: Glued Clamped

1 Steel

3 RMP (SR)

6 Asbestos-Cement

9 Other (specify below)

Welded

2 PVC

4 ABS

7 Fiberglass

Threaded. **✓**Blank casing diameter **2** in. to **7** ft. Dia in. to ft. Dia in. to ft.Casing height above land surface **24** in. weight lbs./ft. Wall thickness or gauge No. **Sch. 40**

TYPE OF SCREEN OR PERFORATION MATERIAL

1 Steel

3 Stainless steel

5 Fiberglass

7 PVC

10 Asbestos-cement

2 Brass

4 Galvanized steel

6 Concrete tile

8 RMP (SR)

11 Other (specify)

9 ABS

12 None used (open hole)

SCREEN OR PERFORATION OPENINGS ARE:

1 Continuous slot

3 Mill slot

5 Gauzed wrapped

8 Saw cut

11 None (open hole)

2 Louvered shutter

4 Key punched

6 Wire wrapped

9 Drilled holes

7 Torch cut

10 Other (specify)

SCREEN-PERFORATED INTERVALS: From **7** ft. to **27** ft. From ft. to ft.

From ft. to ft. From ft. to ft.

GRAVEL PACK INTERVALS: From **5** ft. to **27** ft. From ft. to ft.

From ft. to ft. From ft. to ft.

6 GROUT MATERIAL:

1 Neat cement

2 Cement grout**3** Bentonite

4 Other

Grout Intervals: From **0** ft. to **3** ft. From **3** ft. to **5** ft. From ft. to ft.

What is the nearest source of possible contamination:

1 Septic tank

4 Lateral lines

7 Pit privy

10 Livestock pens

14 Abandoned water well

2 Sewer lines

5 Cess pool

8 Sewage lagoon

11 Fuel storage

15 Oil well/Gas well

3 Watertight sewer lines

6 Seepage pit

9 Feedyard

12 Fertilizer storage

16 Other (specify below)

13 Insecticide storage

Unknown

Direction from well?

How many feet?

FROM	TO	LITHOLOGIC LOG	FROM	TO	PLUGGING INTERVALS
0	3.5	Clay, Black	25	28	Shale, Red
3.5	5.5	Clay, Yellow Brown	28	30	Shale, Yellow Brown
5.5	6.5	Clay, Yellow Brown			
6.5	8	Clay, Yellow			
8	9.5	Clay, Yellow			
9.5	10.5	Clay, Yellow			
10.5	12	Shale, Gray			
12	13.5	Shale, Yellow Gray			
13.5	14.5	Shale, Yellow Gray			
14.5	16	Shale, Gray			
16	17	Shale, Green			
17	17.5	Shale, Green Red			
17.5	19.5	Shale, Red			MW9, Abovegrade
19.5	20.5	Shale, Red			Project Name: Mapco-Conway-G and M
20.5	25	Shale, Red			GeoCore # 121, G and M # OK0584.001

7 CONTRACTOR'S OR LANDOWNER'S CERTIFICATION: This water well was **(1)** constructed, (2) reconstructed, or (3) plugged under my jurisdictionand was completed on (mo/day/year) **10/10/95** and this record is true to the best of my knowledge and belief.Kansas Water Well Contractor's License No. **527** This Water Well Record was completed on (mo/day/yr) **11/10/95**under the business name of **GeoCore Services, Inc.**by (signature) *Dale Roll*