

1 LOCATION OF WATER WELL:	Fraction	Section Number	Township Number	Range Number
County: McPherson	SW ¼ SE ¼ SE ¼	23	T 19 S	R 5 E/W

Distance and direction from nearest town or city street address of well if located within city?

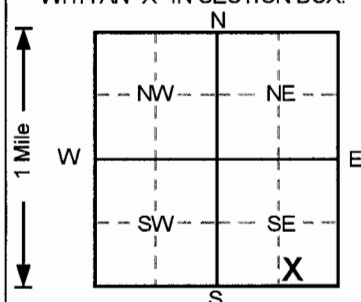
2.5 miles W of Conway, KS on Hwy 562 WATER WELL OWNER: **Mid America Pipeline Co.**RR#, St. Address, Box # : **P.O. Box 1336**

Board of Agriculture, Division of Water Resources

City, State, ZIP Code : **McPherson, Kansas 67460**

Application Number:

3 LOCATE WELL'S LOCATION WITH AN "X" IN SECTION BOX:

4 DEPTH OF COMPLETED WELL **126** ft. ELEVATION:

Depth(s) Groundwater Encountered 1. ft. 2. ft. 3. ft.

WELL'S STATIC WATER LEVEL . . . **41** . . . ft. below land surface measured on mo/day/yrPump test data: Well water was . . . **NA** . . . ft. after hours pumping gpmEst. Yield . . **NA** . . gpm: Well water was ft. after hours pumping gpmBore Hole Diameter . . **7.85** . . in. to . . . **126** . . ft., and in. to ft.

WELL WATER TO BE USED AS: 5 Public water supply 8 Air conditioning 11 Injection well

1 Domestic 3 Feedlot 6 Oil field water supply 9 Dewatering 12 Other (Specify below)

2 Irrigation 4 Industrial 7 Lawn and garden only **10** Monitoring well

Was a chemical/bacteriological sample submitted to Department? Yes.....No✓.....; If yes, mo/day/yr sample was submitted

Water Well Disinfected? Yes No ✓

5 TYPE OF BLANK CASING USED:

5 Wrought iron

8 Concrete tile

CASING JOINTS: Glued Clamped

1 Steel

3 RMP (SR)

6 Asbestos-Cement

9 Other (specify below)

Welded

2 PVC

4 ABS

7 Fiberglass

Threaded. ✓

Blank casing diameter **4** in. to **56** ft., Dia in. to ft., Dia in. to ft.Casing height above land surface **24** in., weight lbs./ft. Wall thickness or gauge No. **Sch. 40**

TYPE OF SCREEN OR PERFORATION MATERIAL

1 Steel

3 Stainless steel

5 Fiberglass

7 PVC

10 Asbestos-cement

2 Brass

4 Galvanized steel

6 Concrete tile

8 RMP (SR)

11 Other (specify)

9 ABS

12 None used (open hole)

SCREEN OR PERFORATION OPENINGS ARE:

1 Continuous slot

3 Mill slot

5 Gauzed wrapped

8 Saw cut

11 None (open hole)

2 Louvered shutter

4 Key punched

6 Wire wrapped

9 Drilled holes

7 Torch cut

10 Other (specify)

SCREEN-PERFORATED INTERVALS: From **56** ft. to **126** ft., From ft. to ft.

From ft. to ft., From ft. to ft.

GRAVEL PACK INTERVALS: From **47.5** ft. to **126** ft., From ft. to ft.

From ft. to ft., From ft. to ft.

6 GROUT MATERIAL:

1 Neat cement

2 Cement grout

3 Bentonite

4 Other

Grout Intervals: From **0** ft. to **43** ft., From **43** ft. to **46** ft., From ft. to ft.

What is the nearest source of possible contamination:

1 Septic tank

4 Lateral lines

7 Pit privy

10 Livestock pens

14 Abandoned water well

2 Sewer lines

5 Cess pool

8 Sewage lagoon

11 Fuel storage

15 Oil well/Gas well

3 Watertight sewer lines

6 Seepage pit

9 Feedyard

12 Fertilizer storage

16 Other (specify below)

13 Insecticide storage

Gas Processing PlantDirection from well? **N**How many feet? **300**

FROM	TO	LITHOLOGIC LOG	FROM	TO	PLUGGING INTERVALS
0	2	Clay, Dark Gray-Black	73	80	Shale, Gray
2	5	Clay, Brown	80	90	Shale, Gray-Green
5	10	Clay, Red-Brown	90	100	Shale, Gray
10	15	Shale, Green	100	102	Shale,
15	18	Shale, Red	102	105	Shale, Gray
18	22	Shale, Green	105	110	Shale, Gray-Green
22	25	Shale, Red-Brown	110	120	Shale, Brown
25	30	Shale, Red-Brick Red			
30	36	Shale, Green			
36	37	Shale, Red			
37	48	Shale, Green			
48	52	Shale, Red			
52	59	Shale, Gray-Black			MW-33-1DO-R, Abovegrade
59	61	Shale, Gray-Green			Project Name: MAPCO-Conway-Deep Well Replacement
61	73	Shale, Brown			GeoCore # 265

7 CONTRACTOR'S OR LANDOWNER'S CERTIFICATION: This water well was **1** constructed, **2** reconstructed, or **3** plugged under my jurisdiction and was completed on (mo/day/year) **10/10/95** and this record is true to the best of my knowledge and belief.

Kansas Water Well Contractor's License No. **527** This Water Well Record was completed on (mo/day/yr) **11/6/95**

under the business name of **GeoCore Services, Inc.** by (signature) *Dale Koller*