

1 LOCATION OF WATER WELL: County: McPherson	Fraction NE ¼ NE ¼ NE ¼	Section Number 23	Township Number T 19 S	Range Number R 5 E/W
---	-----------------------------------	-----------------------------	----------------------------------	--------------------------------

Distance and direction from nearest town or city street address of well if located within city?

2 1/2 mile W, 1 mile N Conway, W side of Road

2 WATER WELL OWNER: **Mid America Pipeline Co.**


RR#, St. Address, Box # : **1800 South Baltimore Ave.**

Board of Agriculture, Division of Water Resources

City, State, ZIP Code : **Tulsa, OK 74101**

Application Number:

3 LOCATE WELL'S LOCATION WITH AN "X" IN SECTION BOX:

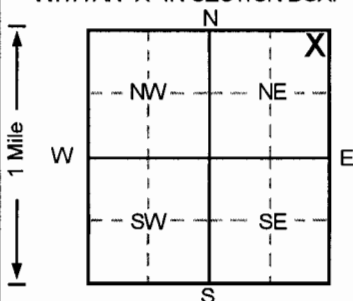

4 DEPTH OF COMPLETED WELL **123** ft. ELEVATION:

Depth(s) Groundwater Encountered 1. ft. 2. ft. 3. ft.

WELL'S STATIC WATER LEVEL . . . **104.71** . . . ft. below land surface measured on mo/day/yr **2/23/96**

Pump test data: Well water was . . . **NA** . . . ft. after hours pumping gpm

Est. Yield . . **NA** . . gpm: Well water was ft. after hours pumping gpm

Bore Hole Diameter . . . **8** . . . in. to **127** ft., and in. to ft.

WELL WATER TO BE USED AS: 5 Public water supply 8 Air conditioning 11 Injection well

1 Domestic 3 Feedlot 6 Oil field water supply 9 Dewatering 12 Other (Specify below)

2 Irrigation 4 Industrial 7 Lawn and garden only **10** Monitoring well

Was a chemical/bacteriological sample submitted to Department? Yes.....No.....; If yes, mo/day/yr sample was submitted

Water Well Disinfected? Yes No

5 TYPE OF BLANK CASING USED:

1 Steel 3 RMP (SR) 5 Wrought iron 8 Concrete tile CASING JOINTS: Glued Clamped

2 PVC 4 ABS 6 Asbestos-Cement 9 Other (specify below) Welded

Blank casing diameter **4** in. to **48** ft., Dia in. to ft., Dia in. to ft.

Casing height above land surface **30** in., weight lbs./ft. Wall thickness or gauge No. **Sch. 40**

TYPE OF SCREEN OR PERFORATION MATERIAL

1 Steel 3 Stainless steel 5 Fiberglass **7** PVC 10 Asbestos-cement

2 Brass 4 Galvanized steel 6 Concrete tile 8 RMP (SR) 11 Other (specify)

SCREEN OR PERFORATION OPENINGS ARE: 5 Gauzed wrapped 8 Saw cut 11 None (open hole)

1 Continuous slot **3** Mill slot 6 Wire wrapped 9 Drilled holes

2 Louvered shutter 4 Key punched 7 Torch cut 10 Other (specify)

SCREEN-PERFORATED INTERVALS: From **48** ft. to **123** ft., From ft. to ft.

From ft. to ft., From ft. to ft.

GRAVEL PACK INTERVALS: From **45** ft. to **127** ft., From ft. to ft.

From ft. to ft., From ft. to ft.

6 GROUT MATERIAL:

1 Neat cement **2** Cement grout **3** Bentonite 4 Other

Grout Intervals: From **0** ft. to **41** ft., From **41** ft. to **45** ft., From ft. to ft.

What is the nearest source of possible contamination:

1 Septic tank 4 Lateral lines 7 Pit privy 10 Livestock pens 14 Abandoned water well

2 Sewer lines 5 Cess pool 8 Sewage lagoon 11 Fuel storage 15 Oil well/Gas well

3 Watertight sewer lines 6 Seepage pit 9 Feedyard 12 Fertilizer storage **16** Other (specify below)

Direction from well? **Unknown**

FROM	TO	LITHOLOGIC LOG	FROM	TO	PLUGGING INTERVALS
0	7	Clay, Dark Brown			
7	10	Shale, Light Green			
10	13	Shale, Red and Green			
13	23	Shale, Light Gray			
23	28	Shale, Brick Red			
28	32	Shale, Light to Medium Gray			
32	41	Shale, Red and Gray			
41	56	Shale, Light Gray			
56	67	Shale, Light to Medium Gray to Red Brown			
67	73	Shale, Red Brown			
73	86	Shale, Red Brown			
86	101	Shale, Red Brown			
101	118	Shale, Red Brown			591DO, Tag #, Abovegrade
118	127	Shale, Red Brown			Project Name: Mapco
					GeoCore # 205, #

7 CONTRACTOR'S OR LANDOWNER'S CERTIFICATION: This water well was **1** constructed, (2) reconstructed, or (3) plugged under my jurisdiction

and was completed on (mo/day/year) **3/28/96** and this record is true to the best of my knowledge and belief.

Kansas Water Well Contractor's License No. **527** This Water Well Record was completed on (mo/day/yr) **4/26/96**

under the business name of **GeoCore Services, Inc.** by (signature) *Paul Roll*