


WATER WELL RECORD Form WWC-5 KSA 82a-1212

1 LOCATION OF WATER WELL: Fraction NW 1/4 NW 1/4 SW 1/4 Section Number 24 Township Number T 19 S Range Number R 5 E **19**  
 County: McPherson

Distance and direction from nearest town or city street address of well if located within city?  
 2 1/2 mile W, 1/2 mi N Conway, E side of Road

2 WATER WELL OWNER: Mid America Pipeline Co.  
 RR#, St. Address, Box # : 1800 South Baltimore Ave. Board of Agriculture, Division of Water Resources  
 City, State, ZIP Code : Tulsa, OK 74101 Application Number:

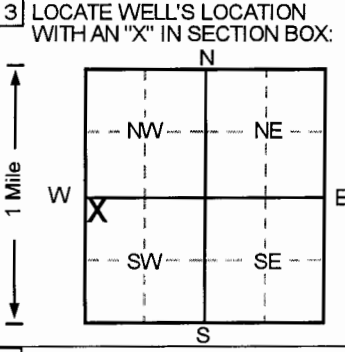

4 DEPTH OF COMPLETED WELL . . . . .161. . . . . ft. ELEVATION: . . . . . ft.  
 Depth(s) Groundwater Encountered 1. . . . . ft. 2. . . . . ft. 3. . . . . ft.  
 WELL'S STATIC WATER LEVEL . . . . . ft. below land surface measured on mo/day/yr  
 Pump test data: Well water was . . . . .NA. . . . . ft. after . . . . . hours pumping . . . . . gpm  
 Est. Yield . . . . .NA. . . . . gpm: Well water was . . . . . ft. after . . . . . hours pumping . . . . . gpm  
 Bore Hole Diameter . . . . .8. . . . . in. to . . . . .161. . . . . ft., and . . . . . in. to . . . . . ft.  
 WELL WATER TO BE USED AS: 5 Public water supply 8 Air conditioning 11 Injection well  
 1 Domestic 3 Feedlot 6 Oil field water supply 9 Dewatering 12 Other (Specify below)  
 2 Irrigation 4 Industrial 7 Lawn and garden only 10 Monitoring well  
 Was a chemical/bacteriological sample submitted to Department? Yes.....No ; If yes, mo/day/yr sample was submitted  
 Water Well Disinfected? Yes No

5 TYPE OF BLANK CASING USED: 5 Wrought iron 8 Concrete tile CASING JOINTS: Glued . . . . . Clamped . . . . .  
 1 Steel 3 RMP (SR) 6 Asbestos-Cement 9 Other (specify below) Welded . . . . .  
 2 **PVC** 4 ABS 7 Fiberglass . . . . . Threaded.   
 Blank casing diameter . . . . .2. . . . . in. to . . . . .141. . . . . ft., Dia . . . . . in. to . . . . . ft., Dia . . . . . in. to . . . . . ft.  
 Casing height above land surface . . . . .30. . . . . in., weight . . . . . lbs./ft. Wall thickness or gauge No. . . . .Sch. 40  
 TYPE OF SCREEN OR PERFORATION MATERIAL 7 **PVC** 10 Asbestos-cement  
 1 Steel 3 Stainless steel 5 Fiberglass 8 RMP (SR) 11 Other (specify) . . . . .  
 2 Brass 4 Galvanized steel 6 Concrete tile 9 ABS 12 None used (open hole)  
 SCREEN OR PERFORATION OPENINGS ARE: 5 Gauzed wrapped 8 Saw cut 11 None (open hole)  
 1 Continuous slot 3 **Mill slot** 6 Wire wrapped 9 Drilled holes  
 2 Louvered shutter 4 Key punched 7 Torch cut 10 Other (specify) . . . . .  
 SCREEN-PERFORATED INTERVALS: From . . . . .141. . . . . ft. to . . . . .161. . . . . ft., From . . . . . ft. to . . . . . ft.  
 From . . . . . ft. to . . . . . ft., From . . . . . ft. to . . . . . ft.  
 GRAVEL PACK INTERVALS: From . . . . .127. . . . . ft. to . . . . .161. . . . . ft., From . . . . . ft. to . . . . . ft.  
 From . . . . . ft. to . . . . . ft., From . . . . . ft. to . . . . . ft.

6 GROUT MATERIAL: 1 Neat cement 2 Cement grout 3 **Bentonite** 4 Other . . . . .  
 Grout Intervals: From . . . . .0. . . . . ft. to . . . . .127. . . . . ft., From . . . . . ft. to . . . . . ft., From . . . . . ft. to . . . . . ft.  
 What is the nearest source of possible contamination:  
 1 Septic tank 4 Lateral lines 7 Pit privy 10 Livestock pens 14 Abandoned water well  
 2 Sewer lines 5 Cess pool 8 Sewage lagoon 11 Fuel storage 15 Oil well/Gas well  
 3 Watertight sewer lines 6 Seepage pit 9 Feedyard 12 Fertilizer storage 16 **Other (specify below)**  
 . . . . .Unknown.  
 Direction from well? How many feet?

FROM	TO	LITHOLOGIC LOG	FROM	TO	PLUGGING INTERVALS

7 CONTRACTOR'S OR LANDOWNER'S CERTIFICATION: This water well was (1) constructed (2) **reconstructed**, or (3) plugged under my jurisdiction and was completed on (mo/day/year) . . . . .3/28/96. . . . . and this record is true to the best of my knowledge and belief.  
 Kansas Water Well Contractor's License No. . . . .527. . . . . This Water Well Record was completed on (mo/day/yr) . . . . .4/26/96. . . . . under the business name of **GeoCore Services, Inc.** by (signature) **Deh Robt**