


1 LOCATION OF WATER WELL: County: McPherson	Fraction E/2W/2 SE 1/4 SW 1/4	Section Number 29	Township Number T 19 S	Range Number R 5 E W
--	----------------------------------	----------------------	---------------------------	-------------------------

Distance and direction from nearest town or city street address of well if located within city?
2 Miles West and 1/4 Mile North of Conway, Ks. on Hwy 56

2	WATER WELL OWNER: Mid America Pipeline Co.	
	RR#, St. Address, Box # : 1300 N Main	Board of Agriculture, Division of Water Resources
	City, State, ZIP Code : McPherson, Ks.	Application Number:

LOCATE WELL'S LOCATION WITH AN "X" IN SECTION BOX: 	4. DEPTH OF COMPLETED WELL.....	24.....	ft.	ELEVATION:.....	1589.67.....
	Depth(s) Groundwater Encountered	1.....	19.....	ft.	2.....
				3.....	ft.

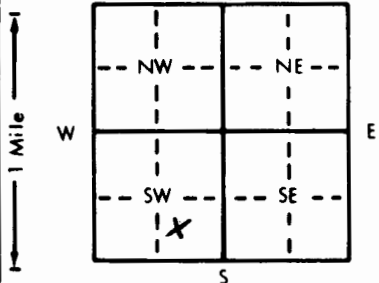

4 DEPTH OF COMPLETED WELL . . . 24 . . . ft. ELEVATION: . . . 1589.67 . . .

Depth(s) Groundwater Encountered 1. . . 19 . . . ft. 2. ft. 3. ft.

WELL'S STATIC WATER LEVEL . . 1.8 - 7 . . . ft. below land surface measured on mo/day/yr . . 12 - 1 - 90 . . .

Pump test data: Well water was ft. after hours pumping gpm

Est. Yield gpm: Well water was ft. after hours pumping gpm

Bore Hole Diameter . . 1.0 . . . in. to . . . 28 . . . ft., and in. to ft.

WELL WATER TO BE USED AS:

1 Domestic	3 Feedlot	6 Oil field water supply	9 Dewatering	12 Other (Specify below)
2 Irrigation	4 Industrial	7 Lawn and garden only	10 Monitoring well	

Was a chemical/bacteriological sample submitted to Department? Yes No If yes, mo/day/yr sample was submitted

Water Well Disinfected? Yes No

5	TYPE OF BLANK CASING USED:	5 Wrought iron	8 Concrete tile	CASING JOINTS: Glued Clamped
	1 Steel	6 Asbestos-Cement	9 Other (specify below)	Welded
	3 RMP (SR)	7 Fiberglass		Threaded. ☒
	2 PVC			
	4 ABS			

Blank casing diameter . . . 4 . . . in. to . . . 14 . . . ft., Dia . . . in. to . . . ft., Dia . . . in. to . . . ft.
Casing height above land surface . . . 24 . . . in., weight . . . lbs./ft. Wall thickness or gauge No. . . Sch. 40

TYPE OF SCREEN OR PERFORATION MATERIAL:				
1 Steel	3 Stainless steel	5 Fiberglass	7 <u>PVC</u>	10 Asbestos-cement
2 Brass	4 Galvanized steel	6 Concrete tile	8 RMP (SR)	11 Other (specify)
			9 ABS	12 None used (open hole)

SCREEN OR PERFORATION OPENINGS ARE:

1 Continuous slot	3 Mill slot	5 Gauzed wrapped	8 Saw cut	11 None (open hole)
2 Louvered shutter	4 Key punched	6 Wire wrapped	9 Drilled holes	
		7 Torch cut	10 Other (specify)	

SCREEN-PERFORATED INTERVALS:	From 24	ft. to 14	ft., From	ft. to	ft.
	From	ft. to	ft., From	ft. to	ft.
GRAVEL PACK INTERVALS:	From 26	ft. to 12	ft., From	ft. to	ft.
	From	ft. to	ft., From	ft. to	ft.

6 GROUT MATERIAL: 1 Neat cement 2 Cement grout 3 Bentonite 4 Other
Grout Intervals: From 12 ft. to 10 (bent) ft. From 12 ft. to 0 (cement) ft. From ft. to ft.

What is the nearest source of possible contamination:

1 Septic tank	4 Lateral lines	7 Pit privy	10 Livestock pens	14 Abandoned water well
2 Sewer lines	5 Cess pool	8 Sewage lagoon	11 Fuel storage	15 Oil well/Gas well
3 Watertight sewer lines	6 Seepage pit	9 Feedyard	12 Fertilizer storage	16 Other (specify below)
			13 Insecticide storage	Brine storage pond...

Direction from well? North

How many feet? 300

[illegible]

7 CONTRACTOR'S OR LANDOWNER'S CERTIFICATION: This water well was (1) constructed, (2) reconstructed, or (3) plugged under my jurisdiction and was completed on (mo/day/year) 12-2-90 and this record is true to the best of my knowledge and belief. Kansas Water Well Contractor's License No. 527 This Water Well Record was completed on (mo/day/yr) 2-4-91 under the business name of GeoCore Services, Inc. by (signature) Dababet