

|                           |                       |                |                 |                |
|---------------------------|-----------------------|----------------|-----------------|----------------|
| 1 LOCATION OF WATER WELL: | Fraction              | Section Number | Township Number | Range Number   |
| County: <b>McPherson</b>  | <b>NE ¼ SE ¼ SE ¼</b> | <b>23</b>      | <b>T 19 S</b>   | <b>R 5 E/W</b> |

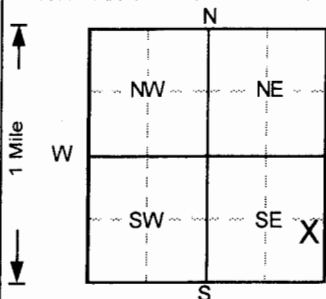
Distance and direction from nearest town or city street address of well if located within city?

**1000' NNW of 5th Ave. & Hwy 56, Conway**2 WATER WELL OWNER: **Williams Mid-Continent Fractionation & Storage**RR#, St. Address, Box # : **1372 7th Ave.**City, State, ZIP Code : **McPherson, Kansas 67460**

Board of Agriculture, Division of Water Resources

Application Number:

3 LOCATE WELL'S LOCATION WITH AN "X" IN SECTION BOX:

4 DEPTH OF COMPLETED WELL: **22** ft. ELEVATION: **1591.15**

Depth(s) Groundwater Encountered 1. ft. 2. ft. 3. ft.

WELL'S STATIC WATER LEVEL: **14.58** ft. below land surface measured on mo/day/yr: **12/6/2010**Pump test data: Well water was **NA** ft. after hours pumping gpmEst. Yield **NA** gpm: Well water was ft. after hours pumping gpmBore Hole Diameter **8** in. to **22** ft. and in. to ft.

WELL WATER TO BE USED AS: 5 Public water supply 8 Air conditioning 11 Injection well

1 Domestic 3 Feedlot 6 Oil field water supply 9 Dewatering 12 Other (Specify below)

2 Irrigation 4 Industrial 7 Lawn and garden only 10 Monitoring well

Was a chemical/bacteriological sample submitted to Department? Yes.....No ☒; If yes, mo/day/yr sample was submittedWater Well Disinfected? Yes No ☒

5 TYPE OF BLANK CASING USED:

1 Steel

3 RMP (SR)

5 Wrought iron

8 Concrete tile

CASING JOINTS: Glued Clamped

2 PVC

4 ABS

6 Asbestos-Cement

9 Other (specify below)

Welded

Blank casing diameter

2 in. to

12 ft. Dia

in. to

ft. Dia

in. to

ft.

Casing height above land surface: **26.88** in., weight lbs./ft. Wall thickness or gauge No. **Sch. 40**

TYPE OF SCREEN OR PERFORATION MATERIAL

1 Steel

3 Stainless steel

5 Fiberglass

8 RMP (SR)

10 Asbestos-cement

2 Brass

4 Galvanized steel

6 Concrete tile

9 ABS

12 None used (open hole)

SCREEN OR PERFORATION OPENINGS ARE:

1 Continuous slot

3 Mill slot

5 Gauzed wrapped

8 Saw cut

11 None (open hole)

2 Louvered shutter

4 Key punched

6 Wire wrapped

9 Drilled holes

SCREEN-PERFORATED INTERVALS:

From

12 ft. to

22 ft.

From

ft. to

ft.

From

ft. to

ft.

From

ft. to

ft.

From

ft. to

ft.

ft.

GRAVEL PACK INTERVALS: From 10 ft. to 22 ft. From ft. to ft. From ft. to ft. From ft. to ft. From ft. to ft.

From ft. to ft. From ft. to ft. From ft. to ft. From ft. to ft. From ft. to ft.

7 CONTRACTOR'S OR LANDOWNER'S CERTIFICATION: This water well was (1) constructed, (2) reconstructed, or (3) plugged under my jurisdiction

and was completed on (mo/day/year) **11/11/2010** and this record is true to the best of my knowledge and belief.Kansas Water Well Contractor's License No. **527** This Water Well Record was completed on (mo/day/yr) **12/10/2010**

under the business name of

**GeoCore, Inc.**

by (signature)

*Joe Holt*