

WATER WELL RECORD Form WWC-5 KSA 82a-1212


1 LOCATION OF WATER WELL: Fraction NW 1/4 NE 1/4 NE 1/4 Section Number 23 Township Number T 19 S Range Number R 5 E/W

Distance and direction from nearest town or city street address of well if located within city?
 2.5 mi W of Conway, .9 mi N on W side of 5th Ave.

2 WATER WELL OWNER: Williams Mid-Continent Fractionation & Storage

RR#, St. Address, Box # : 1372 7th Ave. Board of Agriculture, Division of Water Resources
 City, State, ZIP Code : McPherson, Kansas 67460 Application Number:

3 LOCATE WELL'S LOCATION WITH AN "X" IN SECTION BOX: 4 DEPTH OF COMPLETED WELL 15 ft. ELEVATION: 1546.14

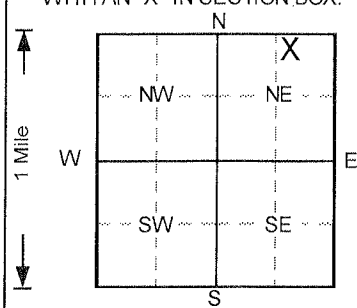

Depth(s) Groundwater Encountered 1. ft. 2. ft. 3. ft.
 WELL'S STATIC WATER LEVEL . . . 8.1 . . . ft. below land surface measured on mo/day/yr . . . 12/15/2011 . . .
 Pump test data: Well water was . . . NA . . . ft. after hours pumping gpm
 Est. Yield . . . NA . . . gpm: Well water was ft. after hours pumping gpm
 Bore Hole Diameter . . . 8. . . in. to . . . 15 . . . ft. and in. to ft.
 WELL WATER TO BE USED AS: 5 Public water supply 8 Air conditioning 11 Injection well
 1 Domestic 3 Feedlot 6 Oil field water supply 9 Dewatering 12 Other (Specify below)
 2 Irrigation 4 Industrial 7 Lawn and garden only 10 Monitoring well
 Was a chemical/bacteriological sample submitted to Department? Yes No ; If yes, mo/day/yr sample was submitted
 Water Well Disinfected? Yes No

5 TYPE OF BLANK CASING USED: 5 Wrought iron 8 Concrete tile CASING JOINTS: Glued Clamped
 1 Steel 3 RMP (SR) 6 Asbestos-Cement 9 Other (specify below) Welded
 2 PVC 4 ABS 7 Fiberglass Threaded.
 Blank casing diameter . . . 2 . . . in. to . . . 13 . . . ft. Dia in. to ft. Dia in. to ft.
 Casing height above land surface . . . 30 . . . in., weight lbs./ft. Wall thickness or gauge No. . . . Sch. 40
 TYPE OF SCREEN OR PERFORATION MATERIAL 7 PVC 10 Asbestos-cement
 1 Steel 3 Stainless steel 5 Fiberglass 8 RMP (SR) 11 Other (specify)
 2 Brass 4 Galvanized steel 6 Concrete tile 9 ABS 12 None used (open hole)
 SCREEN OR PERFORATION OPENINGS ARE: 5 Gauzed wrapped 8 Saw cut 11 None (open hole)
 1 Continuous slot 3 Mill slot 6 Wire wrapped 9 Drilled holes
 2 Louvered shutter 4 Key punched 7 Torch cut 10 Other (specify)
 SCREEN-PERFORATED INTERVALS: From . . . 13 . . . ft. to . . . 15 . . . ft., From ft. to ft.
 GRAVEL PACK INTERVALS: From . . . 11.5 . . . ft. to . . . 15 . . . ft., From ft. to ft.
 From ft. to ft., From ft. to ft.

6 GROUT MATERIAL: 1 Neat cement 2 Cement grout 3 Bentonite 4 Other Concrete
 Grout Intervals: From . . . 0 . . . ft. to . . . 2 . . . ft., From . . . 2 . . . ft. to . . . 11.5 . . . ft., From ft. to ft.
 What is the nearest source of possible contamination:
 1 Septic tank 4 Lateral lines 7 Pit privy 10 Livestock pens 14 Abandoned water well
 2 Sewer lines 5 Cess pool 8 Sewage lagoon 11 Fuel storage 15 Oil well/Gas well
 3 Watertight sewer lines 6 Seepage pit 9 Feedyard 12 Fertilizer storage 16 Other (specify below)
 13 Insecticide storage
 Direction from well? How many feet?

FROM	TO	LITHOLOGIC LOG	FROM	TO	PLUGGING INTERVALS
0	7	Hydrovac,			
7	11	Shale, wthrd., firm, Red			
11	15	Shale, bcmg. sl. wthrd., Red			
					59-3SO, Abovegrade

7 CONTRACTOR'S OR LANDOWNER'S CERTIFICATION: This water well was (1) constructed, (2) reconstructed, or (3) plugged under my jurisdiction and was completed on (mo/day/year) . . . 11/3/2011 . . . and this record is true to the best of my knowledge and belief.
 Kansas Water Well Contractor's License No. . . . 527 . . . This Water Well Record was completed on (mo/day/yr) . . . 12/1/2011 . . .
 under the business name of **GeoCore, Inc.** by signature *Paul Kelly*