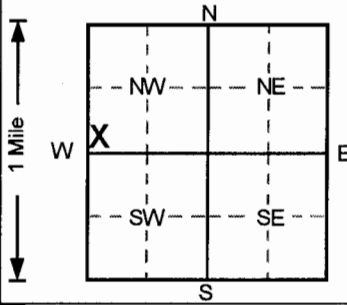


1 LOCATION OF WATER WELL: Fraction **SW 1/4 SW 1/4 NW 1/4** Section Number **26** Township Number **T 19 S** Range Number **R 7 E/W**
 County: **Rice**

Distance and direction from nearest town or city street address of well if located within city?
1/2 m S, 1 1/2 m E, 1/2 m S - E sd of rd-Mitchell

2 WATER WELL OWNER: **Mid America Pipeline Company**
 RR#, St. Address, Box # : **1800 South Baltimore Ave.** Board of Agriculture, Division of Water Resources
 City, State, ZIP Code : **Tulsa, OK 74119** Application Number:

3 LOCATE WELL'S LOCATION WITH AN "X" IN SECTION BOX:


4 DEPTH OF COMPLETED WELL **45** ft. ELEVATION: **1738.03**
 Depth(s) Groundwater Encountered 1. ft. 2. ft. 3. ft.
 WELL'S STATIC WATER LEVEL ft. below land surface measured on mo/day/yr
 Pump test data: Well water was **NA** ft. after hours pumping gpm
 Est. Yield **NA** gpm: Well water was ft. after hours pumping gpm
 Bore Hole Diameter **12** in. to **50** ft., and in. to ft.
 WELL WATER TO BE USED AS: 5 Public water supply 8 Air conditioning 11 Injection well
 1 Domestic 3 Feedlot 6 Oil field water supply 9 Dewatering 12 Other (Specify below)
 2 Irrigation 4 Industrial 7 Lawn and garden only **10** Monitoring well
 Was a chemical/bacteriological sample submitted to Department? Yes.....No; If yes, mo/day/yr sample was submitted
 Water Well Disinfected? Yes No

5 TYPE OF BLANK CASING USED: 5 Wrought iron 8 Concrete tile CASING JOINTS: Glued Clamped
 1 Steel 3 RMP (SR) 6 Asbestos-Cement 9 Other (specify below) Welded
2 PVC 4 ABS 7 Fiberglass Threaded.
 Blank casing diameter **2** in. to **30** ft., Dia in. to ft., Dia in. to ft.
 Casing height above land surface **20.16** in., weight lbs./ft. Wall thickness or gauge No. **Sch. 40**
 TYPE OF SCREEN OR PERFORATION MATERIAL **7** PVC 10 Asbestos-cement
 1 Steel 3 Stainless steel 5 Fiberglass 8 RMP (SR) 11 Other (specify)
 2 Brass 4 Galvanized steel 6 Concrete tile 9 ABS 12 None used (open hole)
 SCREEN OR PERFORATION OPENINGS ARE: 5 Gauzed wrapped 8 Saw cut 11 None (open hole)
 1 Continuous slot **3** Mill slot 6 Wire wrapped 9 Drilled holes
 2 Louvered shutter 4 Key punched 7 Torch cut 10 Other (specify)
 SCREEN-PERFORATED INTERVALS: From **30** ft. to **45** ft., From ft. to ft.
 From ft. to ft., From ft. to ft.
 GRAVEL PACK INTERVALS: From **22** ft. to **45** ft., From ft. to ft.
 From ft. to ft., From ft. to ft.

6 GROUT MATERIAL: 1 Neat cement **2** Cement grout **3** Bentonite 4 Other
 Grout Intervals: From **0** ft. to **19** ft., From **19** ft. to **22** ft., From ft. to ft.
 What is the nearest source of possible contamination:
 1 Septic tank 4 Lateral lines 7 Pit privy 10 Livestock pens 14 Abandoned water well
 2 Sewer lines 5 Cess pool 8 Sewage lagoon 11 Fuel storage 15 Oil well/Gas well
 3 Watertight sewer lines 6 Seepage pit 9 Feedyard 12 Fertilizer storage **16** Other (specify below)
 .. **Brine Ponds**
 Direction from well? **NE** How many feet? **300**

FROM	TO	LITHOLOGIC LOG	FROM	TO	PLUGGING INTERVALS
0	5	Clay, Black			
5	10	Clay, Gray Brown			
10	15	Clay, Red Brown			
15	20	Clay, Tan Brown			
20	25	Silt, Tan Brown			
25	30	Clay, Tan			
30	35	Clay, Tan			
35	36	Sand, Yellow Green			
36	40	Sand, Yellow Green			
40	41	Sand,			
41	47	Clay, Dark Gray			
47	50	Clay, Gray			
					MW13, Abovegrade
					Project Name: G and M, Mapco - Mitchell
					GeoCore # 263, G and M # OK0274.001

7 CONTRACTOR'S OR LANDOWNER'S CERTIFICATION: This water well was **1** constructed, (2) reconstructed, or (3) plugged under my jurisdiction and was completed on (mo/day/year) **10/10/95** and this record is true to the best of my knowledge and belief.
 Kansas Water Well Contractor's License No. **527** This Water Well Record was completed on (mo/day/yr) **11/10/95**
 under the business name of **GeoCore Services, Inc.** by (signature) *Dale Robj*