


1 LOCATION OF WATER WELL: County: **Rice** Fraction **SE 1/4 SW 1/4 NE 1/4** Section Number **27** Township Number **T 19 S** Range Number **R 7** **EW**

Distance and direction from nearest town or city street address of well if located within city?
1/2 m S, 1 1/2 m E, 1/2 m S & 1/4 m W - Mitchell

2 WATER WELL OWNER: **Mid America Pipeline Company**
 RR#, St. Address, Box # : **1800 South Baltimore Ave.** Board of Agriculture, Division of Water Resources
 City, State, ZIP Code : **Tulsa, OK 74119** Application Number:

3 LOCATE WELL'S LOCATION WITH AN "X" IN SECTION BOX:

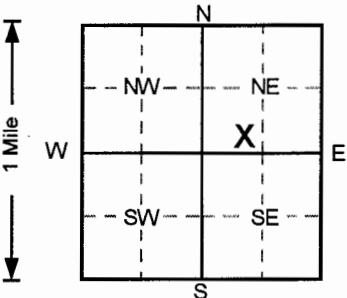

4 DEPTH OF COMPLETED WELL **50** ft. ELEVATION: **1736.34**
 Depth(s) Groundwater Encountered 1. ft. 2. ft. 3. ft.
 WELL'S STATIC WATER LEVEL ft. below land surface measured on mo/day/yr
 Pump test data: Well water was **NA** ft. after hours pumping gpm
 Est. Yield **NA** gpm: Well water was ft. after hours pumping gpm
 Bore Hole Diameter **8** in. to **50** ft., and in. to ft.
 WELL WATER TO BE USED AS: 5 Public water supply 8 Air conditioning 11 Injection well
 1 Domestic 3 Feedlot 6 Oil field water supply 9 Dewatering 12 Other (Specify below)
 2 Irrigation 4 Industrial 7 Lawn and garden only **10** Monitoring well
 Was a chemical/bacteriological sample submitted to Department? Yes.....No; If yes, mo/day/yr sample was submitted Water Well Disinfected? Yes No

5 TYPE OF BLANK CASING USED: 1 Steel 2 **PVC** 3 RMP (SR) 4 ABS 5 Wrought iron 6 Asbestos-Cement 7 Fiberglass 8 Concrete tile 9 Other (specify below) CASING JOINTS: Glued Clamped Welded Threaded
 Blank casing diameter **2** in. to **30** ft., Dia in. to ft., Dia in. to ft.
 Casing height above land surface **28.44** in., weight lbs./ft. Wall thickness or gauge No. **Sch. 40**

TYPE OF SCREEN OR PERFORATION MATERIAL: 1 Steel 2 Brass 3 Stainless steel 4 Galvanized steel 5 Fiberglass 6 Concrete tile 7 **PVC** 8 RMP (SR) 9 ABS 10 Asbestos-cement 11 Other (specify) 12 None used (open hole)

SCREEN OR PERFORATION OPENINGS ARE: 1 Continuous slot 2 Louvered shutter 3 **Mill slot** 4 Key punched 5 Gauzed wrapped 6 Wire wrapped 7 Torch cut 8 Saw cut 9 Drilled holes 11 None (open hole) 10 Other (specify)

SCREEN-PERFORATED INTERVALS: From **30** ft. to **50** ft., From ft. to ft.
 GRAVEL PACK INTERVALS: From **29** ft. to **50** ft., From ft. to ft.

6 GROUT MATERIAL: 1 Neat cement 2 **Cement grout** 3 **Bentonite** 4 Other
 Grout Intervals: From **0** ft. to **26** ft., From **26** ft. to **29** ft., From ft. to ft.
 What is the nearest source of possible contamination: 1 Septic tank 2 Sewer lines 3 Watertight sewer lines 4 Lateral lines 5 Cess pool 6 Seepage pit 7 Pit privy 8 Sewage lagoon 9 Feedyard 10 Livestock pens 11 Fuel storage 12 Fertilizer storage 13 Insecticide storage 14 Abandoned water well 15 Oil well/Gas well **16** Other (specify below) **Brine Ponds**
 Direction from well? **N** How many feet? **500**

FROM	TO	LITHOLOGIC LOG	FROM	TO	PLUGGING INTERVALS
0	4	Clay, Black			
4	5	Clay, Gray			
5	10	Clay, Dark Gray			
10	15	Clay, Red Brown			
15	20	Clay, Red Brown			
20	25	Clay, Red Brown			
25	30	Clay, Red Brown			
30	32	Clay, Red Brown			
32	35	Sand, Orange			
35	40	Sand,			
40	41	Sand, Brown Gray			
41	45	Sand, Gray			
45	48	Clay, Gray			OB3, Abovegrade
48	50	Clay, Gray			Project Name: G and M, Mapco - Mitchell
					GeoCore # 263, G and M # OK0274.001

7 CONTRACTOR'S OR LANDOWNER'S CERTIFICATION: This water well was **(1)** constructed, (2) reconstructed, or (3) plugged under my jurisdiction and was completed on (mo/day/year) **10/10/95** and this record is true to the best of my knowledge and belief.
 Kansas Water Well Contractor's License No. **527** This Water Well Record was completed on (mo/day/yr) **11/10/95**
 under the business name of **GeoCore Services, Inc.** by (signature) *Dale Lobl*