


1 LOCATION OF WATER WELL: County: Rice Fraction NW 1/4 NE 1/4 SE 1/4 Section Number 27 Township Number T 19 S Range Number R 7 E

Distance and direction from nearest town or city street address of well if located within city? ~12 mi. W of McPherson on Hwy 56

2 WATER WELL OWNER: Mid-Continent Fractionation & Storage 1372 Seventh Avenue RR#, St. Address, Box # : McPherson, KS 67460 Board of Agriculture, Division of Water Resources Application Number:

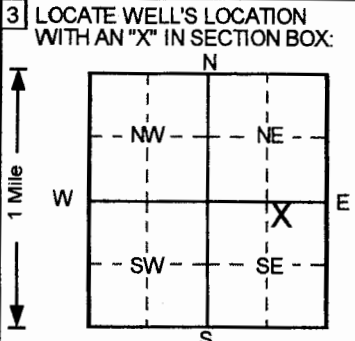

3 LOCATE WELL'S LOCATION WITH AN "X" IN SECTION BOX: 4 DEPTH OF COMPLETED WELL 40.5 ft. ELEVATION: Depth(s) Groundwater Encountered 1. ft. 2. ft. 3. ft. WELL'S STATIC WATER LEVEL 30 ft. below land surface measured on mo/day/yr 2/10/2006 Pump test data: Well water was NA ft. after hours pumping gpm Est. Yield NA gpm: Well water was ft. after hours pumping gpm Bore Hole Diameter 8.25 in. to 40.5 ft., and in. to ft. WELL WATER TO BE USED AS: 5 Public water supply 8 Air conditioning 11 Injection well 1 Domestic 3 Feedlot 6 Oil field water supply 9 Dewatering 12 Other (Specify below) 2 Irrigation 4 Industrial 7 Lawn and garden only 10 Monitoring well Was a chemical/bacteriological sample submitted to Department? Yes No If yes, mo/day/yr sample was submitted Water Well Disinfected? Yes No

5 TYPE OF BLANK CASING USED: 1 Steel 3 RMP (SR) 5 Wrought iron 8 Concrete tile CASING JOINTS: Glued Clamped 2 PVC 4 ABS 6 Asbestos-Cement 9 Other (specify below) Welded Threaded Blank casing diameter 2 in. to 30 ft. Dia in. to ft. Dia in. to ft. Casing height above land surface 30 in., weight lbs./ft. Wall thickness or gauge No. Sch. 40 TYPE OF SCREEN OR PERFORATION MATERIAL 1 Steel 3 Stainless steel 5 Fiberglass 7 PVC 8 RMP (SR) 10 Asbestos-cement 2 Brass 4 Galvanized steel 6 Concrete tile 9 ABS 11 Other (specify) 12 None used (open hole) SCREEN OR PERFORATION OPENINGS ARE: 1 Continuous slot 2 Louvered shutter 3 Mill slot 4 Key punched 5 Gauzed wrapped 6 Wire wrapped 7 Torch cut 8 Saw cut 9 Drilled holes 11 None (open hole) 10 Other (specify) SCREEN-PERFORATED INTERVALS: From 30 ft. to 40 ft. From ft. to ft. From ft. to ft. GRAVEL PACK INTERVALS: From 28 ft. to 40.5 ft. From ft. to ft. From ft. to ft.

6 GROUT MATERIAL: 1 Neat cement 2 Cement grout 3 Bentonite 4 Other Native soil Grout Intervals: From 0 ft. to 1 ft. From 1 ft. to 28 ft. From ft. to ft. What is the nearest source of possible contamination: 1 Septic tank 4 Lateral lines 7 Pit privy 10 Livestock pens 14 Abandoned water well 2 Sewer lines 5 Cess pool 8 Sewage lagoon 11 Fuel storage 15 Oil well/Gas well 3 Watertight sewer lines 6 Seepage pit 9 Feedyard 12 Fertilizer storage 16 Other (specify below) 13 Insecticide storage How many feet?

Direction from well? LITHOLOGIC LOG FROM TO FROM TO PLUGGING INTERVALS 0 2 Silt, sandy, some clay, stiff, Dark Brown 2 5 Clay, some silt, v. stiff, Dark Grayish Brown 5 11 Clay, some silt and sand, Grayish Brown mott 11 32 Clay, some silt, v. stiff, med. plas., Pale Brown 32 35 Clay, some silt, v. stiff, Yellowish Brown 35 40.3 Clay, some silt, tr. to some sand, Lt. Brown OW-3S, Abovegrade Project Name: BM - Mitchell Williams GeoCore # 1276, #

7 CONTRACTOR'S OR LANDOWNER'S CERTIFICATION: This water well was (1) constructed, (2) reconstructed, or (3) plugged under my jurisdiction and was completed on (mo/day/year) 2/8/2006 and this record is true to the best of my knowledge and belief. Kansas Water Well Contractor's License No. 527 This Water Well Record was completed on (mo/day/yr) 2/7/06 under the business name of GeoCore, Inc. by (signature) Dan Roll