


1 LOCATION OF WATER WELL: Fraction **NW 1/4 NE 1/4 SE 1/4** Section Number **27** Township Number **T 19 S** Range Number **R 7 E/W**  
 County: **Rice**

Distance and direction from nearest town or city street address of well if located within city?  
 ~12 mi. W of McPherson on Hwy 56

2 WATER WELL OWNER: **Mid-Continent Fractionation & Storage**  
 1372 Seventh Avenue  
 RR#, St. Address, Box # : **McPherson, KS 67460**  
 City, State, ZIP Code :  
 Board of Agriculture, Division of Water Resources  
 Application Number:

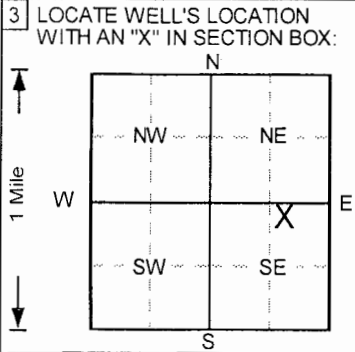

4 DEPTH OF COMPLETED WELL **60** ft. ELEVATION:  
 Depth(s) Groundwater Encountered 1. .... ft. 2. .... ft. 3. .... ft.  
 WELL'S STATIC WATER LEVEL **30** ft. below land surface measured on mo/day/yr **2/10/2006**  
 Pump test data: Well water was **NA** ft. after ..... hours pumping ..... gpm  
 Est. Yield **NA** gpm: Well water was ..... ft. after ..... hours pumping ..... gpm  
 Bore Hole Diameter **8.25** in. to **60** ft., and ..... in. to ..... ft.  
 WELL WATER TO BE USED AS: 5 Public water supply 8 Air conditioning 11 Injection well  
 1 Domestic 3 Feedlot 6 Oil field water supply 9 Dewatering 12 Other (Specify below)  
 2 Irrigation 4 Industrial 7 Lawn and garden only **10** Monitoring well  
 Was a chemical/bacteriological sample submitted to Department? Yes.....No  ; If yes, mo/day/yr sample was submitted  
 Water Well Disinfected? Yes No

5 TYPE OF BLANK CASING USED:  
 1 Steel 3 RMP (SR) 5 Wrought iron 8 Concrete tile CASING JOINTS: Glued ..... Clamped .....  
**2** PVC 4 ABS 6 Asbestos-Cement 9 Other (specify below) Welded .....  
 7 Fiberglass Threaded.   
 Blank casing diameter **2** in. to **50** ft., Dia ..... in. to ..... ft., Dia ..... in. to ..... ft.  
 Casing height above land surface **30** in., weight ..... lbs./ft. Wall thickness or gauge No. **Sch. 40**  
 TYPE OF SCREEN OR PERFORATION MATERIAL **7** PVC 10 Asbestos-cement  
 1 Steel 3 Stainless steel 5 Fiberglass 8 RMP (SR) 11 Other (specify) .....  
 2 Brass 4 Galvanized steel 6 Concrete tile 9 ABS 12 None used (open hole)  
 SCREEN OR PERFORATION OPENINGS ARE:  
 1 Continuous slot **3** Mill slot 5 Gauzed wrapped 8 Saw cut 11 None (open hole)  
 2 Louvered shutter 4 Key punched 6 Wire wrapped 9 Drilled holes  
 7 Torch cut 10 Other (specify) .....  
 SCREEN-PERFORATED INTERVALS: From **50** ft. to **60** ft., From ..... ft. to ..... ft.  
 From ..... ft. to ..... ft., From ..... ft. to ..... ft.  
 GRAVEL PACK INTERVALS: From **48** ft. to **60** ft., From ..... ft. to ..... ft.  
 From ..... ft. to ..... ft., From ..... ft. to ..... ft.

6 GROUT MATERIAL: 1 Neat cement 2 Cement grout **3** Bentonite **4** Other **Native soil**  
 Grout intervals: From **0** ft. to **1** ft., From **1** ft. to **48** ft., From ..... ft. to ..... ft.  
 What is the nearest source of possible contamination:  
 1 Septic tank 4 Lateral lines 7 Pit privy 10 Livestock pens 14 Abandoned water well  
 2 Sewer lines 5 Cess pool 8 Sewage lagoon 11 Fuel storage 15 Oil well/Gas well  
 3 Watertight sewer lines 6 Seepage pit 9 Feedyard 12 Fertilizer storage 16 Other (specify below)  
 13 Insecticide storage  
 Direction from well? How many feet?

FROM	TO	LITHOLOGIC LOG	FROM	TO	PLUGGING INTERVALS
0	2	Silt, sandy, some clay, stiff, Dark Brown			
2	5.4	Clay, some silt, v. stiff, Dark Grayish Brown			
5.4	11	Clay, some silt and sand, Grayish Brown mottl			
11	32	Clay, some silt, v. stiff, Pale Brown grading to			
32	34	Silt, some clay, stiff to v. stiff, Lt. Yellowish Br			
34	40	Clay, some silt, tr. to some sand, Lt. Brown			
40	43	Clay and caliche, some silt, tr. sand, Lt. Brown			
43	45.5	Shale, soft, mod. weathered, Dk Yellowish Ora			
45.5	60	Shale, silty, v. soft to soft, mod. weathered, Yel			
					OW-4D, Abovegrade
					Project Name: BM - Mitchell Williams
					GeoCore # 1276, #

7 CONTRACTOR'S OR LANDOWNER'S CERTIFICATION: This water well was **1** constructed, (2) reconstructed, or (3) plugged under my jurisdiction and was completed on (mo/day/year) **2/7/2006** and this record is true to the best of my knowledge and belief.  
 Kansas Water Well Contractor's License No. **527** This Water Well Record was completed on (mo/day/yr) **2/28/06**  
 under the business name of **GeoCore, Inc.** by (signature) *Dale Ball*