


1 LOCATION OF WATER WELL:	Fraction	Section Number	Township Number	Range Number
County: Rice	SW 1/4 NE 1/4 SE 1/4	27	T 19 S	R 7 E W

Distance and direction from nearest town or city street address of well if located within city?
 ~3700'S of Hwy 56 / 1200'W of 23rd Rd., Mitchell

2 WATER WELL OWNER:	Mid-Continent Fractionation & Storage 1372 Seventh Avenue McPherson, KS 67460	Board of Agriculture, Division of Water Resources Application Number:
RR#, St. Address, Box #		
City, State, ZIP Code		

3 LOCATE WELL'S LOCATION WITH AN "X" IN SECTION BOX:

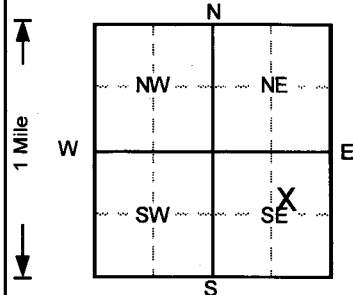

4 DEPTH OF COMPLETED WELL	45 ft	ELEVATION:	1732.01
Depth(s) Groundwater Encountered	1. ft.	2. ft.	3. ft.
WELL'S STATIC WATER LEVEL	32.77 ft. below land surface	measured on mo/day/yr	1/17/2007
Pump test data:	Well water was NA ft. after hours pumping	 gpm
Est. Yield	NA gpm:	Well water was ft. after hours pumping gpm
Bore Hole Diameter	8 in. to 45 ft., and in. to ft.		
WELL WATER TO BE USED AS:	5 Public water supply	8 Air conditioning	11 Injection well
	1 Domestic	3 Feedlot	6 Oil field water supply
	2 Irrigation	4 Industrial	7 Lawn and garden only
			10 Monitoring well
Was a chemical/bacteriological sample submitted to Department?	Yes No <input checked="" type="checkbox"/>	If yes, mo/day/yr sample was submitted	
Water Well Disinfected?	Yes	No <input checked="" type="checkbox"/>	

5 TYPE OF BLANK CASING USED:	1 <input checked="" type="radio"/> Steel	2 PVC	3 RMP (SR)	4 ABS	5 Wrought iron	6 Asbestos-Cement	7 Fiberglass	8 Concrete tile	9 Other (specify below)	CASING JOINTS: Glued Clamped		
Blank casing diameter	4 in. to 29.5 ft., Dia	4 in. to 45 ft., Dia										
Casing height above land surface	29.16 in., weight									lbs./ft. Wall thickness or gauge No. Sch. 80		
TYPE OF SCREEN OR PERFORATION MATERIAL	1 Steel	2 Brass	3 Stainless steel	4 Galvanized steel	5 Fiberglass	6 Concrete tile	7 <input checked="" type="radio"/> PVC	8 RMP (SR)	9 ABS	10 Asbestos-cement	11 Other (specify)	12 None used (open hole)
SCREEN OR PERFORATION OPENINGS ARE:	1 Continuous slot	2 Louvered shutter	3 <input checked="" type="radio"/> Mill slot	4 Key punched	5 Gauzed wrapped	6 Wire wrapped	7 Torch cut	8 Saw cut	9 Drilled holes	10 Other (specify)	11 None (open hole)	
SCREEN-PERFORATED INTERVALS:	From 29.5 ft. to 44.5 ft.,	From ft. to ft.,	From ft. to ft.,	From ft. to ft.,	From ft. to ft.,	From ft. to ft.,	From ft. to ft.,	From ft. to ft.,	From ft. to ft.,	From ft. to ft.,	From ft. to ft.,	From ft. to ft.,
GRAVEL PACK INTERVALS:	From 23 ft. to 45 ft.,	From ft. to ft.,	From ft. to ft.,	From ft. to ft.,	From ft. to ft.,	From ft. to ft.,	From ft. to ft.,	From ft. to ft.,	From ft. to ft.,	From ft. to ft.,	From ft. to ft.,	From ft. to ft.,

6 GROUT MATERIAL:	1 Neat cement	2 Cement grout	3 <input checked="" type="radio"/> Bentonite	4 <input checked="" type="radio"/> Other Concrete													
Grout Intervals:	From 0 ft. to 3 ft.,	From 3 ft. to 3 ft.,	From 3 ft. to 23 ft.,	From ft. to ft.													
What is the nearest source of possible contamination:	1 Septic tank	2 Sewer lines	3 Watertight sewer lines	4 Lateral lines	5 Cess pool	6 Seepage pit	7 Pit privy	8 Sewage lagoon	9 Feedyard	10 Livestock pens	11 Fuel storage	12 Fertilizer storage	13 Insecticide storage	14 Abandoned water well	15 Oil well/Gas well	16 Other (specify below)	
Direction from well?																	

FROM	TO	LITHOLOGIC LOG	FROM	TO	PLUGGING INTERVALS
0	2.5	Clay, silty (topsoil), V. Dark Grayish Brown			
2.5	7.5	Clay, silty, Dark Brown			
7.5	11	Silt, clayey, Yellowish Brown			
11	15	Silt, clayey, Dark Yellowish Brown			
15	25	Clay, silty, Dark Yellowish Brown			
25	28	Clay, silty, Yellowish Brown			
28	30	Clay, silty, Dark Yellowish Brown			
30	32	Caliche, tr. clay, V. Pale Brown			
32	38	Clay, tr. silt, Dark Yellowish Brown			
38	42	Gravel, clayey, Lt. Yellowish Brown			
42	45	Shale, highly weathered, Lt. Brownish Gray			
					RW8, Abovegrade
					Project Name: BM - Mitchell Williams
					GeoCore # 1276, #

7 CONTRACTOR'S OR LANDOWNER'S CERTIFICATION:	This water well was <input checked="" type="radio"/> (1) constructed, (2) reconstructed, or (3) plugged under my jurisdiction and was completed on (mo/day/year) 7/17/2007 and this record is true to the best of my knowledge and belief.
Kansas Water Well Contractor's License No.	527 This Water Well Record was completed on (mo/day/yr) 8/11/2008
under the business name of	GeoCore, Inc. by (signature) <i>Don Hall</i>