


1 LOCATION OF WATER WELL: County: Mitchell Rice Fraction SE 1/4 NE 1/4 NW 1/4 Section Number 26 Township Number T 19 S Range Number R 7 E/W

Distance and direction from nearest town or city street address of well if located within city? ~800' S of Hwy 56 / 2600' E of 23rd Rd., Rice Co.

2 WATER WELL OWNER: Williams Mid-Continent Fractionation & Storage RR#: St. Address, Box #: 1372 7th Ave. Board of Agriculture, Division of Water Resources City, State, ZIP Code: McPherson, Kansas 67460 Application Number:

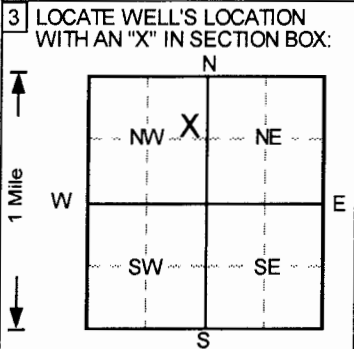

3 LOCATE WELL'S LOCATION WITH AN 'X' IN SECTION BOX: 4 DEPTH OF COMPLETED WELL: 30 ft. ELEVATION: 1725.77. WELL'S STATIC WATER LEVEL: 19.45 ft. below land surface measured on 8/4/2010. Pump test data: Well water was NA ft. after NA hours pumping. Est. Yield NA gpm. Bore Hole Diameter 8 in. to 30 ft. and in. to ft. WELL WATER TO BE USED AS: 10 Monitoring well. Was a chemical/bacteriological sample submitted to Department? Yes No. Water Well Disinfected? Yes No.

5 TYPE OF BLANK CASING USED: 1 Steel, 2 PVC, 3 RMP (SR), 4 ABS, 5 Wrought iron, 6 Asbestos-Cement, 7 Fiberglass, 8 Concrete tile, 9 Other (specify below). CASING JOINTS: Glued, Clamped, Welded, Threaded. Blank casing diameter .2 in. to 20 ft. Dia. Casing height above land surface 13.2 in., weight lbs./ft. Wall thickness or gauge No. Sch. 40. TYPE OF SCREEN OR PERFORATION MATERIAL: 1 Steel, 2 Brass, 3 Stainless steel, 4 Galvanized steel, 5 Fiberglass, 6 Concrete tile, 7 PVC, 8 RMP (SR), 10 Asbestos-cement, 11 Other (specify), 12 None used (open hole). SCREEN OR PERFORATION OPENINGS ARE: 1 Continuous slot, 2 Louvered shutter, 3 Mill slot, 4 Key punched, 5 Gauzed wrapped, 6 Wire wrapped, 7 Torch cut, 8 Saw cut, 11 None (open hole), 9 Drilled holes, 10 Other (specify). SCREEN-PERFORATED INTERVALS: From 20 ft. to 30 ft. GRAVEL PACK INTERVALS: From 18 ft. to 30 ft.

6 GROUT MATERIAL: 1 Neat cement, 2 Cement grout, 3 Bentonite, 4 Other. Grout Intervals: From 0 ft. to 2 ft., From 2 ft. to 18 ft. What is the nearest source of possible contamination: 1 Septic tank, 2 Sewer lines, 3 Watertight sewer lines, 4 Lateral lines, 5 Cess pool, 6 Seepage pit, 7 Pit privy, 8 Sewage lagoon, 9 Feedyard, 10 Livestock pens, 11 Fuel storage, 12 Fertilizer storage, 13 Insecticide storage, 14 Abandoned water well, 15 Oil well/Gas well, 16 Other (specify below). Direction from well? How many feet?

Table with columns: FROM, TO, LITHOLOGIC LOG, FROM, TO, PLUGGING INTERVALS. Rows include: 0-7 Open Hole (Hydrovac), 7-10 Clay, silty, Dark Brown mottled Red Brown, 10-16.5 Clay, silty, Yellow Brown, 16.5-20 Clay, abundant fine caliche nod., sl. silty, Lt. Y, 20-26.5 Clay, w/decr. caliche, Yellow Brown, 26.5-29 Sand, vf-f., Yellow Brown, 29-30 Sandstone, caliche cem., vf, White. MW355, Abovegrade.

7 CONTRACTOR'S OR LANDOWNER'S CERTIFICATION: This water well was (1) constructed, (2) reconstructed, or (3) plugged under my jurisdiction and was completed on (mo/day/year) 8/5/2010 and this record is true to the best of my knowledge and belief. Kansas Water Well Contractor's License No. 527. This Water Well Record was completed on (mo/day/yr) 9/1/2010 under the business name of GeoCore, Inc. by (signature) Dan Bell.