


1 LOCATION OF WATER WELL: County: MITCHELL Rice Fraction: NE 1/4 NW 1/4 NW 1/4 Section Number: 26 Township Number: T 19 S Range Number: R 7 **EW**

Distance and direction from nearest town or city street address of well if located within city?
 ~70' S of Hwy 56 / 550' E of 23rd Rd., Rice Co.

2 WATER WELL OWNER: **Williams Mid-Continent Fractionation & Storage**
 RR#, St. Address, Box # : 1372 7th Ave. Board of Agriculture, Division of Water Resources
 City, State, ZIP Code : McPherson, Kansas 67460 Application Number:

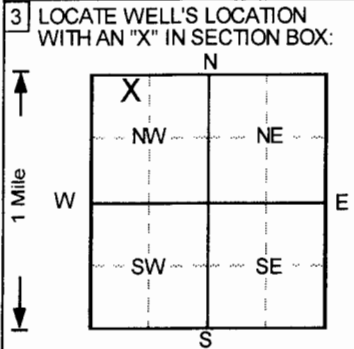

4 DEPTH OF COMPLETED WELL: 38 ft. ELEVATION: 1736.59
 Depth(s) Groundwater Encountered 1. 1 ft. 2. 1 ft. 3. 1 ft.
 WELL'S STATIC WATER LEVEL: 32.09 ft. below land surface measured on mo/day/yr 8/4/2010
 Pump test data: Well water was NA ft. after NA hours pumping NA gpm
 Est. Yield NA gpm: Well water was NA ft. after NA hours pumping NA gpm
 Bore Hole Diameter 8 in. to 38 ft., and NA in. to NA ft.
 WELL WATER TO BE USED AS: 5 Public water supply 8 Air conditioning 11 Injection well
 1 Domestic 3 Feedlot 6 Oil field water supply 9 Dewatering 12 Other (Specify below)
 2 Irrigation 4 Industrial 7 Lawn and garden only **10** Monitoring well
 Was a chemical/bacteriological sample submitted to Department? Yes NA No ; If yes, mo/day/yr sample was submitted
 Water Well Disinfected? Yes NA No

5 TYPE OF BLANK CASING USED: 1 Steel 3 RMP (SR) 5 Wrought iron 8 Concrete tile CASING JOINTS: Glued NA Clamped NA
 2 **PVC** 4 ABS 7 Fiberglass Welded NA
 Blank casing diameter 2 in. to 28 ft., Dia. NA in. to NA ft., Dia. NA in. to NA ft.
 Casing height above land surface 34.32 in., weight NA lbs./ft. Wall thickness or gauge No. Sch. 40
 TYPE OF SCREEN OR PERFORATION MATERIAL: 7 **PVC** 10 Asbestos-cement
 1 Steel 3 Stainless steel 5 Fiberglass 8 RMP (SR) 11 Other (specify) NA
 2 Brass 4 Galvanized steel 6 Concrete tile 9 ABS 12 None used (open hole)
 SCREEN OR PERFORATION OPENINGS ARE: 3 **Mill slot** 11 None (open hole)
 1 Continuous slot 2 Louvered shutter 4 Key punched 5 Gauzed wrapped 6 Wire wrapped 7 Torch cut 8 Saw cut 9 Drilled holes 10 Other (specify) NA
 SCREEN-PERFORATED INTERVALS: From 28 ft. to 38 ft. From NA ft. to NA ft. From NA ft. to NA ft.
 GRAVEL PACK INTERVALS: From 24.4 ft. to 38 ft. From NA ft. to NA ft. From NA ft. to NA ft.

6 GROUT MATERIAL: 1 Neat cement 2 **Cement grout** 3 Bentonite 4 **Other Concrete**
 Grout Intervals: From 0 ft. to 2 ft. From 2 ft. to 20.1 ft. From 20.1 ft. to 24.4 ft.
 What is the nearest source of possible contamination:
 1 Septic tank 4 Lateral lines 7 Pit privy 10 Livestock pens 14 Abandoned water well
 2 Sewer lines 5 Cess pool 8 Sewage lagoon 11 Fuel storage 15 Oil well/Gas well
 3 Watertight sewer lines 6 Seepage pit 9 Feedyard 12 Fertilizer storage 16 Other (specify below) NA
 13 Insecticide storage
 Direction from well? NA How many feet? NA

FROM	TO	LITHOLOGIC LOG	FROM	TO	PLUGGING INTERVALS
0	5.5	Open Hole (Hydrovac),			
5.5	10	Clay, abundant caliche, Brown			
10	14	Clay, as above w/decr. moisture,			
14	18	Clay, abundant caliche, Yellow Brown			
18	20	Sand, vf-f, Brown			
20	20.5	Clay, abundant caliche, Brown			
20.5	25	Sand, vf-f, Brown			
25	30	Sand, vf-f, sl. clayey stringers, Brown to Yello			
30	38	Sand, vf, silty, Red Yellow			
					MW34S, Abovegrade

7 CONTRACTOR'S OR LANDOWNER'S CERTIFICATION: This water well was **1** constructed, (2) reconstructed, or (3) plugged under my jurisdiction and was completed on (mo/day/year) 8/5/2010 and this record is true to the best of my knowledge and belief.
 Kansas Water Well Contractor's License No. 527 This Water Well Record was completed on (mo/day/yr) 9/17/2010
 under the business name of GeoCore, Inc. by (signature) Dale Bell

INSTRUCTIONS: Use typewriter or ball point pen. PLEASE PRESS FIRMLY and PRINT clearly. Please fill in blanks, underline or circle the correct answers. Send top three copies to Kansas Department of Health and Environment, Bureau of Water, Topeka, Kansas 66620-0001. Telephone: 913-296-5545. Send one to WATER WELL OWNER and retain one for your records.