


1 LOCATION OF WATER WELL: Fraction SE 1/4 NE 1/4 Section Number 27 Township Number T 19 S Range Number R 7 **E/W**

Distance and direction from nearest town or city street address of well if located within city?  
 ~2550' S of Hwy 56 / 100' W of 23rd Rd., Rice Co.

2 WATER WELL OWNER: Williams Mid-Continent Fractionation & Storage  
 RR#, St. Address, Box #: 1372 7th Ave. Board of Agriculture, Division of Water Resources  
 City, State, ZIP Code: McPherson, Kansas 67460 Application Number:

3 LOCATE WELL'S LOCATION WITH AN "X" IN SECTION BOX:

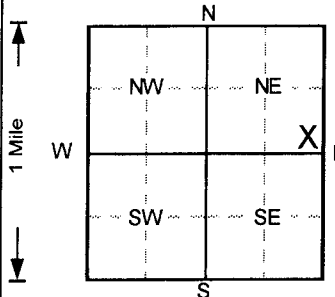

4 DEPTH OF COMPLETED WELL: 39.5 ft ELEVATION: 1740.4  
 Depth(s) Groundwater Encountered 1. ft 2. ft 3. ft  
 WELL'S STATIC WATER LEVEL: 36.98 ft below land surface measured on mo/day/yr 8/4/2010  
 Pump test data: Well water was NA ft after hours pumping gpm  
 Est. Yield NA gpm Well water was ft after hours pumping gpm  
 Bore Hole Diameter 8 in. to 41 ft. and in. to ft.  
 WELL WATER TO BE USED AS: 5 Public water supply 8 Air conditioning 11 Injection well  
 1 Domestic 3 Feedlot 6 Oil field water supply 9 Dewatering 12 Other (Specify below)  
 2 Irrigation 4 Industrial 7 Lawn and garden only **10 Monitoring well**  
 Was a chemical/bacteriological sample submitted to Department? Yes.....No ; If yes, mo/day/yr sample was submitted  
 Water Well Disinfected? Yes No

5 TYPE OF BLANK CASING USED: 1 Steel 3 RMP (SR) 5 Wrought iron 8 Concrete tile CASING JOINTS: Glued Clamped  
 2 **PVC** 4 ABS 6 Asbestos-Cement 9 Other (specify below) Welded  
 7 Fiberglass Threaded   
 Blank casing diameter 2 in. to 29.5 ft, Dia in. to ft, Dia in. to ft  
 Casing height above land surface 36.48 in., weight lbs./ft. Wall thickness or gauge No. Sch. 40  
 TYPE OF SCREEN OR PERFORATION MATERIAL: 7 **PVC** 10 Asbestos-cement  
 1 Steel 3 Stainless steel 5 Fiberglass 8 RMP (SR) 11 Other (specify)  
 2 Brass 4 Galvanized steel 6 Concrete tile 9 ABS 12 None used (open hole)

SCREEN OR PERFORATION OPENINGS ARE: 3 **Mill slot** 5 Gauzed wrapped 8 Saw cut 11 None (open hole)  
 1 Continuous slot 6 Wire wrapped 9 Drilled holes  
 2 Louvered shutter 4 Key punched 7 Torch cut 10 Other (specify)

SCREEN-PERFORATED INTERVALS: From 29.5 ft to 39.5 ft, From ft to ft  
 GRAVEL PACK INTERVALS: From 26.7 ft to 39.5 ft, From ft to ft

6 GROUT MATERIAL: 1 Neat cement 2 **Cement grout** 3 Bentonite 4 **Other Concrete**  
 Grout Intervals: From 0 ft to 2 ft, From 2 ft to 22.5 ft, From 22.5 ft to 26.7 ft  
 What is the nearest source of possible contamination:  
 1 Septic tank 4 Lateral lines 7 Pit privy 10 Livestock pens 14 Abandoned water well  
 2 Sewer lines 5 Cess pool 8 Sewage lagoon 11 Fuel storage 15 Oil well/Gas well  
 3 Watertight sewer lines 6 Seepage pit 9 Feedyard 12 Fertilizer storage 16 Other (specify below)  
 13 Insecticide storage  
 Direction from well? How many feet?

FROM	TO	LITHOLOGIC LOG	FROM	TO	PLUGGING INTERVALS
0	7	Open Hole (Hydrovac by another company),			
7	12.5	Clay, tr. carbonaceous material, Brown			
12.5	25	Clay, abundant caliche, Brown			
25	28.5	Clay, decr. caliche, rare lig., Brown			
28.5	35	Clay, tr. caliche, Brown to Red Brown			
35	39	Clay, abundant caliche, Yellow Brown			
39	40	Sandstone, vf grained, Brown to Gray Green			
					MW29S, Abovegrade

7 CONTRACTOR'S OR LANDOWNER'S CERTIFICATION: This water well was **1** constructed, (2) reconstructed, or (3) plugged under my jurisdiction and was completed on (mo/day/year) 8/5/2010 and this record is true to the best of my knowledge and belief.  
 Kansas Water Well Contractor's License No. 527 This Water Well Record was completed on (mo/day/yr) 9/1/2010  
 under the business name of GeoCore, Inc. by (signature) Dale Roll

INSTRUCTIONS: Use typewriter or ball point pen. PLEASE PRESS FIRMLY and PRINT clearly. Please fill in blanks, underline or circle the correct answers. Send top three copies to Kansas Department of Health and Environment, Bureau of Water, Topeka, Kansas 66620-0001. Telephone: 913-296-5545. Send one to WATER WELL OWNER and retain one for your records.