

1 LOCATION OF WATER WELL:	Fraction	Section Number	Township Number	Range Number
County: <u>Mitchell Rice</u>	SW $\frac{1}{4}$ SW $\frac{1}{4}$ NE $\frac{1}{4}$	27	T 19 S	R 7 <u>EW</u>

Distance and direction from nearest town or city street address of well if located within city?

~2550' S of Hwy 56 / 2600' W of 23rd Rd., Rice Co.

## 2 WATER WELL OWNER: Williams Mid-Continent Fractionation &amp; Storage


RR#, St. Address, Box # : 1372 7th Ave.

City, State, ZIP Code : McPherson, Kansas 67460

Board of Agriculture, Division of Water Resources

Application Number:

## 3 LOCATE WELL'S LOCATION WITH AN "X" IN SECTION BOX:

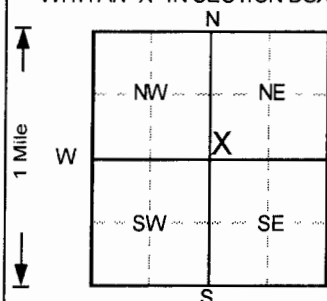

## 4 DEPTH OF COMPLETED WELL: 150 ft. ELEVATION: 1730.48

Depth(s) Groundwater Encountered 1. ft. 2. ft. 3. ft.

WELL'S STATIC WATER LEVEL: 148.85 ft. below land surface measured on mo/day/yr 8/4/2010

Pump test data: Well water was NA ft. after hours pumping gpm

Est. Yield NA gpm: Well water was ft. after hours pumping gpm

Bore Hole Diameter 6 in. to 150 ft. and in. to ft.

WELL WATER TO BE USED AS: 5 Public water supply 8 Air conditioning 11 Injection well

1 Domestic 3 Feedlot 6 Oil field water supply 9 Dewatering 12 Other (Specify below)

2 Irrigation 4 Industrial 7 Lawn and garden only 10 Monitoring well

Was a chemical/bacteriological sample submitted to Department? Yes No ☒ ; If yes, mo/day/yr sample was submittedWater Well Disinfected? Yes No ☒

## 5 TYPE OF BLANK CASING USED:

1 Steel 3 RMP (SR)

2 PVC 4 ABS

5 Wrought iron

6 Asbestos-Cement

7 Fiberglass

8 Concrete tile

9 Other (specify below)

CASING JOINTS: Glued Clamped

Welded

Threaded ☒

Blank casing diameter 2 in. to 140 ft. Dia in. to ft. Dia in. to ft.

Casing height above land surface 32.52 in., weight lbs./ft. Wall thickness or gauge No. Sch. 80

## TYPE OF SCREEN OR PERFORATION MATERIAL

1 Steel 3 Stainless steel

2 Brass 4 Galvanized steel

5 Fiberglass

6 Concrete tile

7 PVC

8 RMP (SR)

9 ABS

10 Asbestos-cement

11 Other (specify)

12 None used (open hole)

## SCREEN OR PERFORATION OPENINGS ARE:

1 Continuous slot 3 Mill slot

2 Louvered shutter 4 Key punched

5 Gauzed wrapped

6 Wire wrapped

7 Torch cut

8 Saw cut

9 Drilled holes

10 Other (specify)

11 None (open hole)

SCREEN-PERFORATED INTERVALS: From 140 ft. to 150 ft. From ft. to ft. From ft. to ft.

From ft. to ft. From ft. to ft. From ft. to ft.

GRAVEL PACK INTERVALS: From 135 ft. to 152 ft. From ft. to ft. From ft. to ft.

From ft. to ft. From ft. to ft. From ft. to ft.

From ft. to ft. From ft. to ft. From ft. to ft.

7 CONTRACTOR'S OR LANDOWNER'S CERTIFICATION: This water well was (1) constructed, (2) reconstructed, or (3) plugged under my jurisdiction and was completed on (mo/day/year) 8/5/2010 and this record is true to the best of my knowledge and belief.

Kansas Water Well Contractor's License No. 527 This Water Well Record was completed on (mo/day/yr) 9/1/2010

under the business name of GeoCore, Inc. by (signature) Duke Relf